


Section 2 Township 32 Range 7E
Well No. 6 Rogers
Company Texas Co.

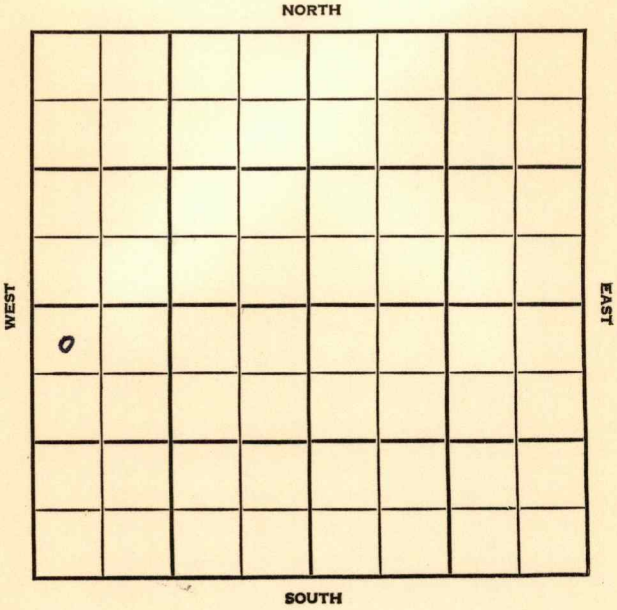

Cowley

KANSAS

SEC.	TWP.	R.
2	32	7E

WELL NO.

#6 Rogers

FARM

COMPANY

Texas Company

CONTRACTOR

Capitt Drlg.

School Creek Pool

330

Ft. from N. Line

Ft. from S. Line

Ft. from E. Line

330

Ft. from W. Line

WEST

EAST

SOUTH

NW NW SW

	ELEVATION	REPORT
1955	1421'	

1/19 Location

2/16

Oil well TD 2498' Stal. 1718
 Layton 2091 KC 2082 Cleve 2444'
 DST 2443-63, open 2 hr rec 65' GCM
 310# TD 2498 7" @ 2497
 CO 42/2150-64 S/2200' wtr.
 S/18 BO 27 BW 18 hr. 500 A
 S/24 BO 25 BW sd-frac.
 F/161 BO 8 BW 8 hr. F/45 BO 3 hr.
 Comp. F/360 BOPD

COMPLETED

County Cowley State Kansas
 Sec. 2 (Blk.) 32 (Sur.) 7E Map No.
 Operator Texas Company
 Well No. 6 Farm Rogers
 Elev. _____ Location NW NW SW

0					

FIRST REPORT

330 Ft. From N Line SW
330 Ft. From W Line Quarter

1st. Report JAN 1 9 1955

Completion _____

Remarks _____

Capitt Drlg. - Contr.

Spudding Date _____

Drlg. Data _____

School Creek Pool

Location

FABEN GILSTRAP

County Cowley State Kansas
 Sec. 2 (Blk.) 32 (Sur.) 7E Map No.
 (Twp.) (Rge.)

Operator Texas Company

Well No. 6 Farm Rogers

Elev. 1421 Location NW NW SW

330 Ft. From N Line SW

330 Ft. From W Line Quarter

1st. Report

Completion FEB 1 6 1955

Remarks School Creek Pool
Capitt Drlg. - Contr.

Spudding Date

Drlg. Data Oil well TD 2498

Stal. 1718 Layton 2091 KC 2082

Cleve. 2444 DST 2443-63 open 2 hr.

Rec. 65' gcm 310# TD 2498 7" @ 2497

CO 42/ 2150-64 S/ 2200' wtr.

S/ 18 bo 27 bw 18 hr. 500 A

S/ 24 bo 25 bw sd-frac F/ 161 bo

8 bw 8 hr. F/ 45 bo 3 hr.

Comp. F/ 360 bopd

FABEN GILSTRAP