


Section 2 Township 32 Range 7E

Well No. #5 C.W. Rogers.

Company Texas Company

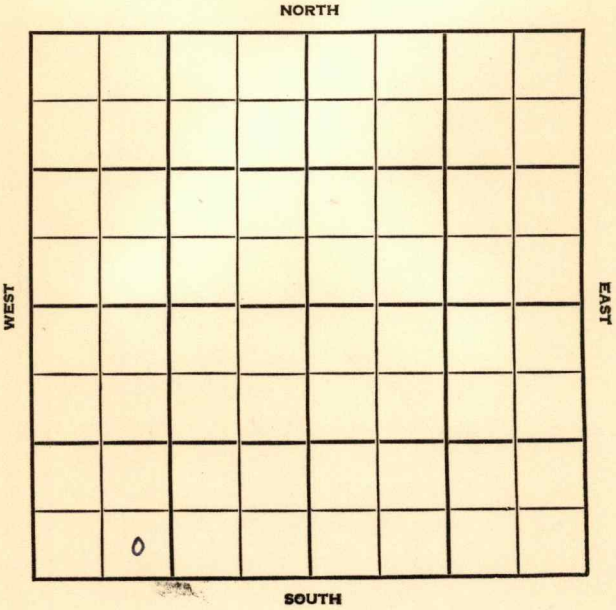

Cowley KANSAS


SEC.	TWP.	R.
2	32	7E

WELL NO. _____
 5 C. W. Rogers _____ FARM
 COMPANY

Texas Co.
 CONTRACTOR

Capitt
 N. School Creek Pool

_____ Ft. from N. Line
 330 _____ Ft. from S. Line
 _____ Ft. from E. Line
 990 _____ Ft. from W. Line

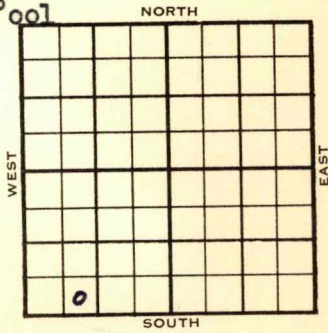

SE SW SW

	ELEVATION	REPORT
1954	1414'	

12/1 Spud 11-28-54
 10" @ 166'

12/22 Spud 11-28-54 Oil well TD 2158
 10" @ 166 Top. 1025 Doug 1560
 Total. 1728 Layton 2094 TD 2158
 7" @ 2140 CO to 2158 S/285 GO
 20 GW 7½ hr. 200 A S/10 BO 4 BW
 4 hr. P/57 BO 3 BW 12 hr.
 Comp. 25 BOPD 3% wtr.

COMPLETED

