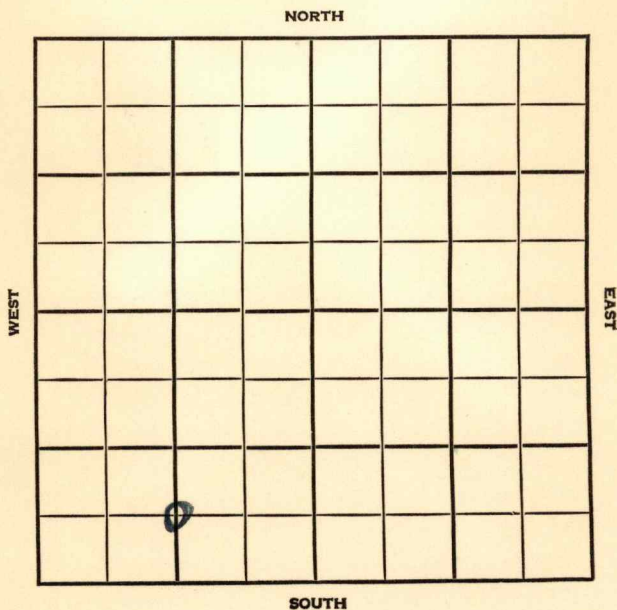


Section 2 Township 32 Range 7EWell No. 8 C. W. Rogers SWDCompany Texas Company

Cowley

KANSAS

SEC.	TWP.	R.
2	32	7E

WELL NO.

8 C. W. Rogers SWD

FARM

COMPANY

Texas Company

CONTRACTOR

Capitt


School Creek

_____ Ft. from N. Line

_____ Ft. from S. Line

_____ Ft. from E. Line

_____ Ft. from W. Line

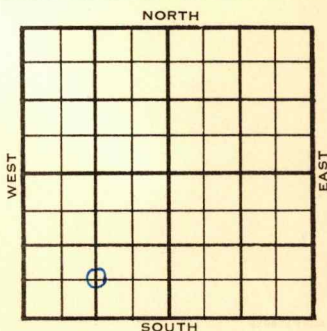~~S. 34~~ C S $\frac{1}{2}$ SW

1955

ELEVATION

1407'

REPORT

6/29

M I R

7/13

Comm 6-29-55, 10 3/4" @127/100 7" @175
 CO to 1805 in put 1 1/2 hr. Comp.
 33 bw 100# SWD well

Tops:

Depth

Datum

H. Stal

1720

313

TD.

1805

ABANDONED

County Cowley Elev. _____
 Sec. 2 Twp. 32 Rge. 7E
 Company Texas Company
 Farm Name C. W. Rogers SWD No. 8

TOPS	DEPTH	LOG	DATUM	Loc. in Sec.
Anh.				<u>C S $\frac{1}{2}$ SW</u>
Tp.				
H.				
Tr.				
Dg.				
Bl.				
L.				Geol. _____
K.C.				Contr. _____
B.K.C.				<u>Capitt</u>
Ce.				Pool _____
C.				<u>School Creek</u>
M.				
M.				
K.				
Mz.				
Me.				
V.				
S.				
S.				
A.				
R.				
Pe.				
G.				
T.D.				

FIRST REPORT
 JUN 29 1955

Date Comm. _____

M I R

County Cowley Elev. 1407
 Sec. 2 Twp. 32 Rge. 7E
 Company Texas Company
 Farm Name C. W. Rogers SWD No. 8

TOPS	DEPTH	LOG	DATUM	Loc. in Sec.
Anh.				C S $\frac{1}{2}$ SW
TP. <u>Stal</u>	<u>1720</u>		<u>313</u>	
H.				
Tr.				
Dg.				
Bl.				
L.				Geol.
K.C.				Contr.
B.K.C.				<u>Capitt</u>
Ce.				
C.				Pool
M.				<u>School Creek</u>
M.				
K.				
Mz.				
Mq.				
V.				
S.				
S.				
A				
R.				
PE.				
G.				
T.D.	<u>180.5</u>			

ABANDONED

Date Comm. 6-28-55 JUL 13 195510 3/4" @ 127/100 7" @ 1751 CO to1805 input 13 bw 1 hr.Comp. 33 bw 100# SWD well