


Section 3 Township 32 Range 7E

Well No. 1 ~~Hendrickson~~ ANKROM.

Company ~~H. H. Blair et al~~ TEXAS CO.

Misc. NORTH

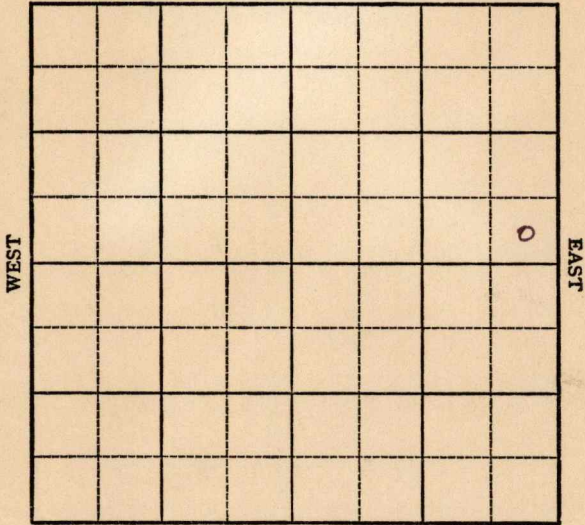

SOUTH

O.W.W.O. Cowley

Sec. 3 **KANSAS** Twp. 32 R. 7-E

Well No. 1 Hendrickson ANKRDM Farm

H. H. Blair et al Company

Miscellaneous


TEXAS COMPANY
NORTH

_____ Ft. from N. Line

330 Ft. from S. Line

330 Ft. from E. Line

_____ Ft. from W. Line

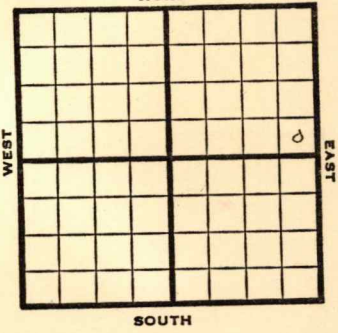

SE NE

1947

Elev. 1403' REPORT

9/3

Loc.

9/10

"

9/17

"

9/24

"

10/1

8" @ 165'

10/8

Drlg! 2146'

10/15

"

10/22

Miss 2901'
Total Depth 2968'

ABANDONED

1955
3/16

O.W.W.O.

Oil Well
TD 2969'

Top 975' Hoover 1232' Doug. 1557'
Haskell 1657', Stal. 1733', Lans 1842'
KC 2070', Layton 2138', KC 2206' Cleve.
2413', Marm 2472' Oswego 2553' Miss
2906'

OTD 2969' CO to TD
5½" @ 2489'
CO to 2454 perf 2140-46
S/ 97 bo 398 bw. 24 hr.
Comp 40 bopd. 100 bw.

**FIRST REPORT
COMPLETED**

County **Cowley** State **Kansas**

Sec. **3** (Blk. **32**) (Sur. **7E**) (Twp.) (Rge.) Map No.

Operator **Texas Company**

O.W.W.O.

Well No. **1** Farm **Ankrom**

Elev. **1403** Location **SE SE NE**

FIRST REPORT

COMPLETE

330 Ft. From **S** Line **NE**

330 Ft. From **E** Line Quarter

1st. Report **MAR 1 6 1955**

Completion **MAR 1 6 1955**

Remarks **OWWO**

O.W.W.O.

Spudding Date

Drlg. Data **Oil well TD 2969**

Top. 975 Hoover 1232 Doug. 1557

Haskell 1657 Stal. 1733 Lans. 1842

KC 2070 Layton 2138 KC 2206

Cleve. 2413 Marm. 2472 Oswego 2553

Miss. 2906 OTD 2969 CO to TD

5 1/2" @ 2489 CO to 2454 perf/ 2140-46

S/ 97 bo 398 bw 24 hr.

Comp. 40 bopd 100 bw

FABEN GILSTRAP

Map No. _____ Sec. 3 Twp. 32 R. 7E

Well No. 1 Hendrickson

H. H. Blair et al. Company

FIRST REPORT Contractor

SE NE

SECTION PLAT

_____ Ft. from N. Line

330 Ft. from S. Line

330 Ft. from E. Line

_____ Ft. from W. Line

Cowley County

Location X

Rig up _____

Drilling and Remarks:

RECORD

Cased _____ in., _____ ft.

Sand _____

Gas _____

Oil _____

Total Depth _____

PRODUCTION

1st 24 hrs. Nat. _____

1st 24 hrs. after shot _____

Gas _____ Cu. Ft.

Dry Hole _____

Abandoned _____

Date

SEP 3 1947 19

S. J. LEWIS Scout

Kansas Miscellaneous

Map No. 3 Sec. 3 Twp. 32 R. 7E

Well No. 1 Hendrickson

B.B. Blair etal. Company

ABANDONED

Contractor

E. J. 1403

SE NE

SECTION PLAT

			0

_____ Ft. from N. Line

330 Ft. from S. Line

330 Ft. from E. Line

_____ Ft. from W. Line

Cowley County

Location _____

Rig up _____

Drilling and Remarks:

See 2901

RECORD

Cased _____ in., _____ ft.

Sand _____

Gas _____

Oil _____

Total Depth 2965

PRODUCTION

1st 24 hrs. Nat. _____

1st 24 hrs. after shot _____

Gas _____ Cu. Ft.

Dry Hole _____

Abandoned _____

Date

OCT 22 1947 19

S. J. LEWIS Scout