


Section 29 Township 25 Range 4EWell No. 3 EverettCompany Rex & Morris

NORTH

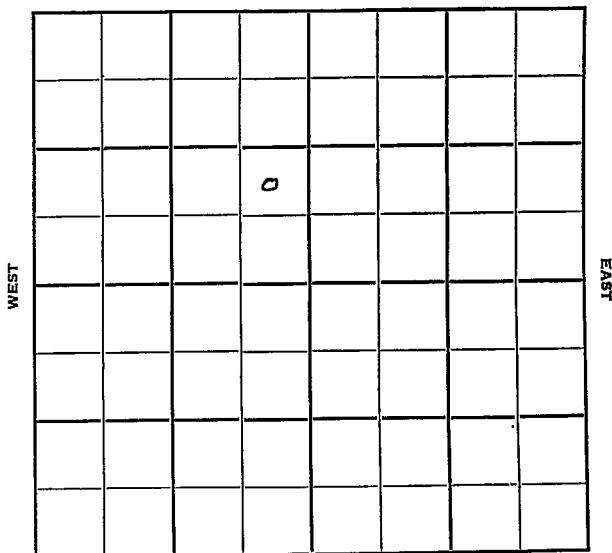

SOUTH

Sec. 29 Twp. 25 R. 4E ✓

Well No. #3 Everett Farm

Rex & Morris Company

Contractor


 Ft. from N. Line

990' Ft. from S. Line

330' Ft. from E. Line

 Ft. from W. Line

NE SE NW

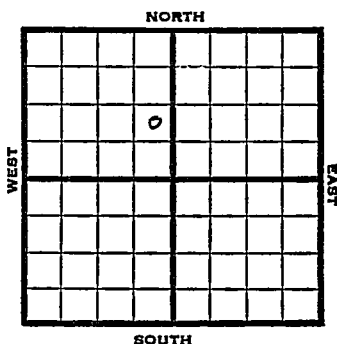

1951 Elev. 1354' REPORT

7/25

Location

9/5

Spud 7-27-51

Oil Well TD 2692

8" @ 100

Chat 2537 Viola 2690-92

5" @ 2691 FU 1900' fluid 18 hr.

Comp. 20 bopd 50 bw

COMPLETED

J. E. TYRA

County Butler State Kansas
 Sec. 29 (Blk.) 25 (Sur.) 4E Map No.
 Operator Rex & Morris
 Well No. 3 Farm Everett
 Elev. 1354 Location NE SE NW

		0			

990 Ft. From S Line NW

330 Ft. From E Line Quarter

1st. Report

Completion SEP 5 1951

Remarks

Spudding Date 7-27-51

Drilg. Data Oil well TD 2692

8" @ 100 Chat 2537 Viola 2690-92 TD

5" @ 2691 FU 1900' fluid 18 hr.

Comp. 20 bopd 50 bw