


Section 3 Township 32 Range 7E

Well No. 2 D. S. Ankrom

Company Texas Co.

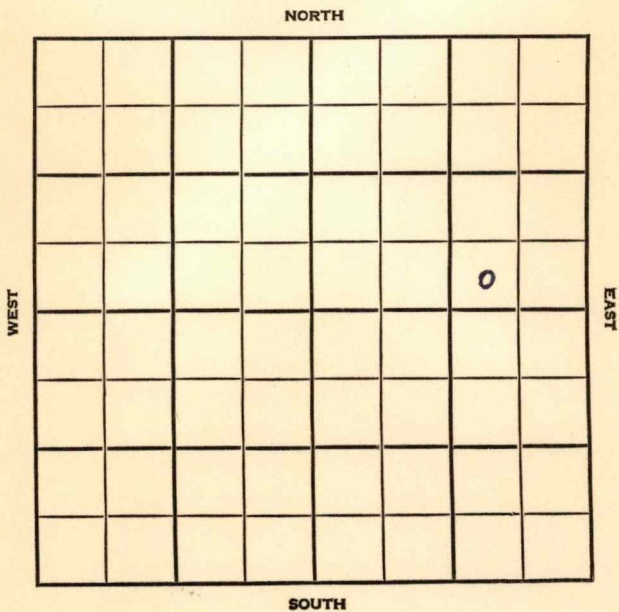

Cowley

KANSAS

SEC.	TWP.	R.
3	32	7E

WELL NO. _____

COMPANY #2 D.S. Ankrom FARM

CONTRACTOR Texas Company

Capitt

N.School Creek Pool NORTH

_____ Ft. from N. Line

330 _____ Ft. from S. Line

990 _____ Ft. from E. Line

_____ Ft. from W. Line

SW SE NE

	ELEVATION	REPORT
1955	1412'	
2/16	Spud 2-12-55 10" @ 127' Drlg. 1240'	
3/23	Spud 2-12-55, oil well, TD 2248 10" @ 127, Top 983, Doug 1565 Stal. 1743. Lans 1851, kc 2073; Layton 2081, Layton sd 2135, TD 2248, 7" @ 2246, 18/ 2142-48, S/35 go, 32 GW 6 hr, frac S/18 BO 18 BWPH S/18 BO 16 BW 15 hr frac P/16 BO 77 BW 15 hr Comp 33 BOPD 37 BW	

COMPLETED

