


Section 3 Township 32 Range 7E

Well No. #1 Barger

Company Helmerich & Payne

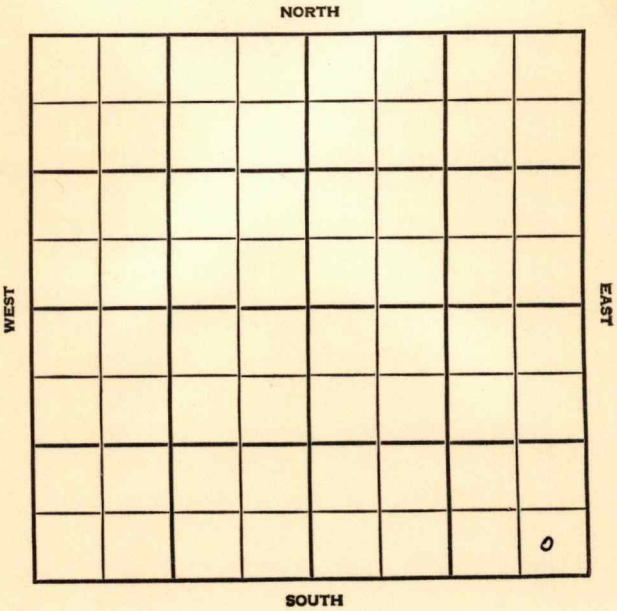

Cowley

KANSAS

SEC.	TWP.	R.
3	32	7 E

WELL NO. _____

1 Barger FARM

COMPANY _____

Helmerich & Payne

CONTRACTOR _____

School Creek Pool


_____ Ft. from N. Line

330 _____ Ft. from S. Line

330 _____ Ft. from E. Line

_____ Ft. from W. Line

SE SE SE

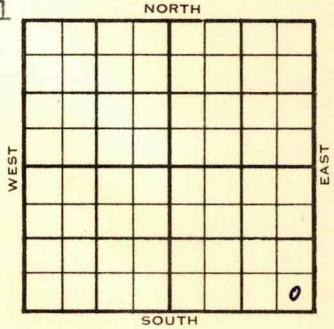

	ELEVATION	REPORT
1954	1419'	

8/18 Spud 8-15-54
8" @ 65 Drlg. 1434'

9/1 Spud 8-15-54 - Oil Well
TD 2466'
8" @ 65'
Dayton 2126', Cleve 2408'
TD 2466'
5" @ 2465'
91/2138-53 SO
Frac
F/124 bo 4 hrs.
F 200 bo 4 hrs.
Comp. 25 bopd

COMPLETED

