


Section 18 Township 16 Range 10W

Well No. 1 Novotny

Company Black-Marshall
Bloomer

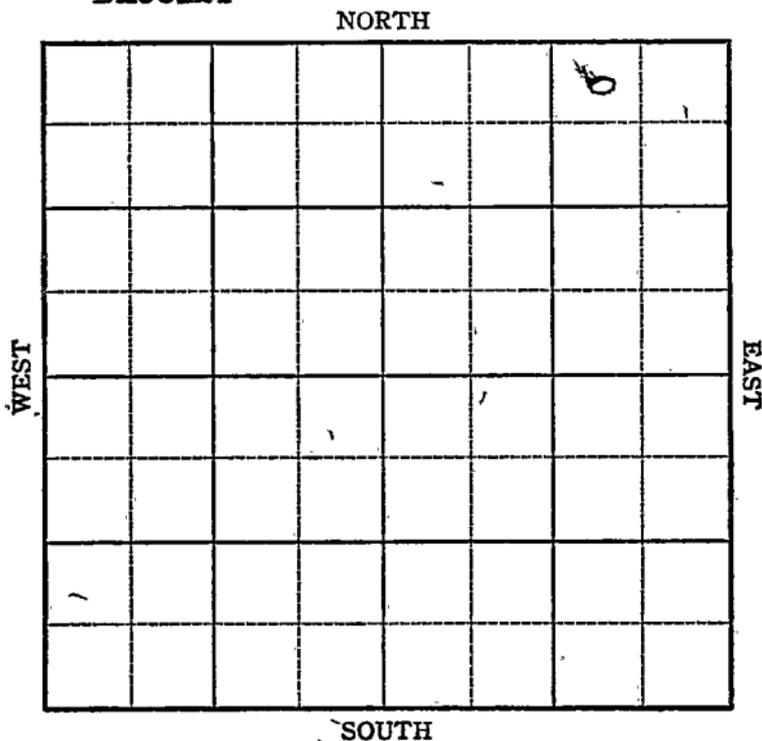

Sec. 18 Twp. 16 R. 10-W


Well No. #1 Novotny Farm
Black-Marshall Company

330 Ft. from N. Line

_____ Ft. from S. Line

990 Ft. from E. Line

_____ Ft. from W. Line

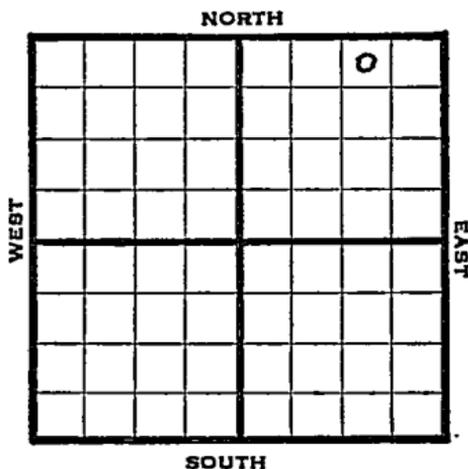

NW NE NE

1947 Elev. 1899' REPORT

4/9 Location

4/15 RUR

4/23 8" @ 358'
Drlg 2915'

4/30 Lans 3062
Cong 3360
Arb 3392
TD 3400'

ABANDONED

Map No. 155 Sec. 18 Twp. 16 R. 10W

Well No. 1 Novotny

Black-Marshall

Company

FIRST REPORT

Contractor

NW NE NE

SECTION PLAT

			o

330 Ft. from N. Line

_____ Ft. from S. Line

990 Ft. from E. Line

_____ Ft. from W. Line

Ellsworth County

Location X

Rig up _____

Drilling and Remarks:

RECORD

Cased _____ in., _____ ft.

Sand _____

Gas _____

Oil _____

Total Depth _____

PRODUCTION

1st 24 hrs. Nat. _____

1st 24 hrs. after shot _____

Gas _____ Cu. Ft.

Dry Hole _____

Abandoned _____

Date

APR 9 1947 19

S. J. LEWIS Scout

KANSAS
Kansas

Bloomer Pool

Map No. 55 Sec. 18 Twp. 16 R. 10W

Well No. 1 Novotny

Black-Marshall

Company

ABANDONED

Contractor

NW NE NE

E 11899
SECTION PLAT

			o

330 Ft. from N. Line

_____ Ft. from S. Line

990 Ft. from E. Line

_____ Ft. from W. Line

Ellsworth County

RECORD

Location _____

Cased _____ in., _____ ft.

Rig' up _____

Sand _____

Drilling and Remarks:

Gas _____

Oil _____

Total Depth 3400

Lane 3062
Conq 3360
Cur 3392

PRODUCTION

1st 24 hrs. Nat. _____

1st 24 hrs. after shot _____

Gas _____ Cu. Ft.

Dry Hole _____

Abandoned _____

Date

APR 30 1947 19

S. J. LEWIS Scout