

Section 29 Township 25 Range 4EWell No. #1 JohnsonCompany Rex & Morris

NORTH

WEST

			0				

EAST

SOUTH

Butler

KANSAS

Sec. 29 Twp. 25 R. 4 E ✓

Well No. # 1 Johnson Farm

Rex & Morris Company

Contractor


 Ft. from N. Line

330 Ft. from S. Line

330 Ft. from E. Line

 Ft. from W. Line

SE SE NW

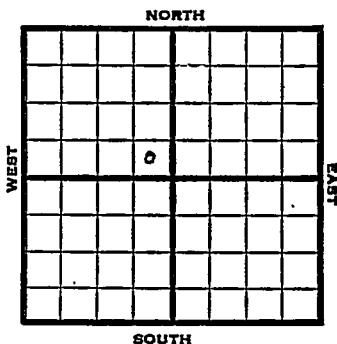

1951

Elev. 1356' REPORT

2/21

Location

4/4

Spud 3-6-51

Oil Well TD 2702

13" @ 240 10" @ 1690

Miss 2525' Viola 2700

7" @ 2700-02 TD

Comp. 35 bopd

COMPLETED

County **Butler** State **Kansas**

Sec. 29 (Blk. Twp.) 25 (Sur. Rge.) 4E Map No.

Operator Rex & Morris

Well No. **1** Farm **Johnson**

Elev.	Location	SE SE NW
330 Ft. From S Line NW

330 Ft. From E Line Quarter

1st. Report FEB 21 1951

Completion

Remarks


Spudding Date _____

Drlq. Data

Location

J. E. TYRA

County Butler State Kansas
 Sec. 29 (Blk.
Twp.) 25 (Sur.
Rge.) 4E Map No.
 Operator Rex & Morris
 Well No. 1 Farm Johnson
 Elev. 1356 Location SE SE NW

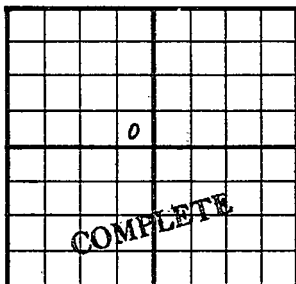

330 Ft. From S Line NW
330 Ft. From E Line Quarter

1st. Report

Completion APR 4 1951

Remarks

Spudding Date 3-6-51

Drlg. Data Oil well TD 2702
13" @ 240 10" @ 1690 Miss. 2525
Viola 2700 7" @ 2700-02 TD
Comp. 35 bopd

J. E. TYRA