

KANSAS

Form 51-5M-7-39-Palace

Ellsworth


Section 18 Township 16 Range 10-W

Well No. #1 Kozisek

Company Mabee Drilling

Stoltenberg Pool

NORTH

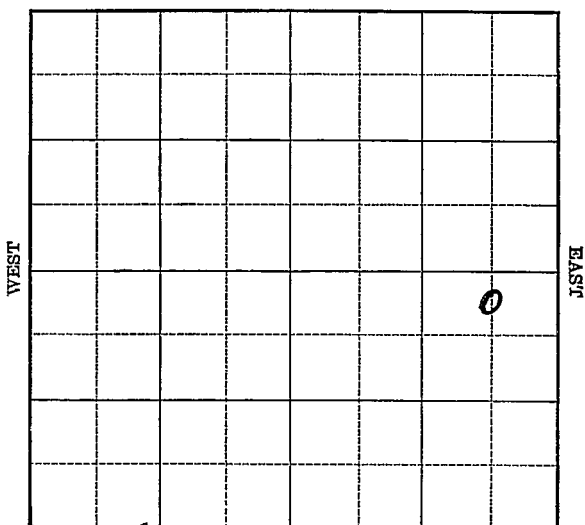

SOUTH

9

WEST

EAST

Sec. 18 Twp. 16 R. 10-W

Well No. #1 Kozisek Farm

Mabee Drilling Company

(Stoltenberg)


330 Ft. from N. Line

_____ Ft. from S. Line

660 Ft. from E. Line

_____ Ft. from W. Line

Elev. 1885

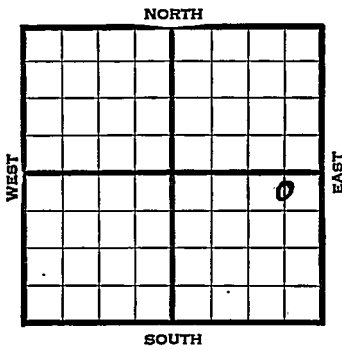

1940	REPORT
5/8	Derrick.
5/16	10" - 332' Anhy 690'
	Drlg. 1030'
5/23	Drlg. 2640'
5/29	Arb. 3395'
	T.D. 3420'
	No shows.
	ABANDONED

Map No. 55 Sec. 18 Twp. 16 R. 10W.Well No. 1 KozisekMabee Drilling

Company

Contractor

FIRST REPORT**SECTION PLAT****C N L N E S E**330 Ft. from N. Line

_____ Ft. from S. Line

660 Ft. from E. Line

_____ Ft. from W. Line

			o

STOLTENBERG POOL

Location _____

Rig up _____

Drilling and Remarks:

Derrick**RECORD**

Cased _____ in., _____ ft.

Sand _____

Gas _____

Oil _____

Total Depth _____

PRODUCTION

1st: 24 hrs. Nat. _____

1st 24 hrs. after shot _____

Gas _____ Cu. Ft.

Dry Hole _____

Abandoned _____

Date

MAY 8 1940 19S. J. LEWIS Scout

Map No. 55 Sec. 18 Twp. 16 R. 10W

Well No. 1 Kozisek

Mabee Drilling Company

Contractor

ABANDONED

C N L N E S E

330 Ft. from N. Line

_____ Ft. from S. Line

660 Ft. from E. Line

_____ Ft. from W. Line

STOLTENBERG POOL

SECTION PLAT

			o

Location _____

Rig up _____

Drilling and Remarks:

Cr. 8.3895

No shows

RECORD

Cased _____ in., _____ ft.

Sand _____

Gas _____

Oil _____

Total Depth 3420

PRODUCTION

1st 24 hrs. Nat. _____

1st 24 hrs. after shot _____

Gas _____ Cu. Ft.

Dry Hole _____

Abandoned _____

Date

MAY 29 1940 19

S. J. LEWIS Scout