

KANSAS

Ellsworth


Form 51-5M-7-39-Palace

Section 18 Township 16 Range 10-W

Well No. #1 ~~Kozisek~~ Novonty

Company Herndon Drilling

NORTH Stoltenberg Pool

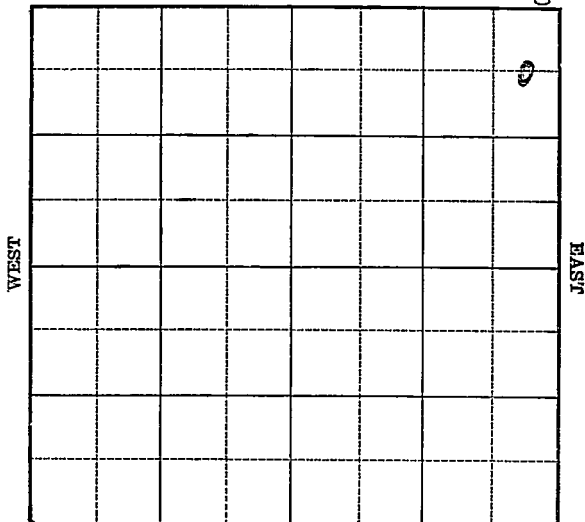

[illegible]

Map No. 55 Sec. 18 Twp. 16 R. 10WWell No. 1 KozisekHerndon Drilling CompanyContractor**FIRST REPORT****C E L N E N E**660 Ft. from N. Line Ft. from S. Line330 Ft. from E. Line Ft. from W. Line**STOLTENBERG POOL****SECTION PLAT**

Location Rig up

Drilling and Remarks:

10" - 364Dr1g 2350**RECORD**Cased in., ft.Sand Gas Oil Total Depth **PRODUCTION**1st 24 hrs. Nat. 1st 24 hrs. after shot Gas Cu. Ft.Dry Hole Abandoned

Date

JUN 26 194019S. J. LEWIS Scout

Map No. _____ Sec. 18 Twp. 16 R. 10WWell No. 1 Novotny


Herndon Drilling

Company

CORRECTION

Contractor

SECTION PLAT

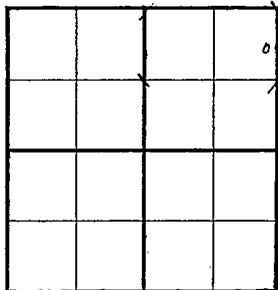

C E L N E N E

660 Ft. from N. Line

_____ Ft. from S. Line

330 Ft. from E. Line

_____ Ft. from W. Line

STOLTENBERG POOL

Location _____

Rig up _____

Drilling and Remarks:

Reported

as #1 Kozisek

RECORD

Cased _____ in., _____ ft.

Sand _____

Gas _____

Oil _____

Total Depth _____

PRODUCTION

1st 24 hrs. Nat. _____

1st 24 hrs. after shot _____

Gas _____ Cu. Ft.

Dry Hole _____

Abandoned _____

Date

JUL 10 1940

19

S. J. LEWIS Scout

Map No. 55 Sec. 18 Twp. 16 R. 10WWell No. 1 KozisekHerndon Drilling Company

Contractor


COMPLETED

C E L N E N E

660 Ft. from N. Line Ft. from S. Line330 Ft. from E. Line Ft. from W. Line

STOLTENBERG POOL

SECTION PLAT

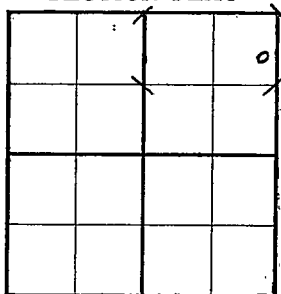Location Rig up Drilling and Remarks: 3000 acidPump pot.
427 bbls.

RECORD

Cased in., ft.Shot 3375Gas Oil Total Depth 3405

PRODUCTION

1st 24 hrs. Nat. 1st 24 hrs. after shot Gas Cu. Ft.Dry Hole Abandoned

Date

III 31 1940 19S. J. LEWIS Scout