


Section 20 Township 16 Range 10-W

Well No. #1 Haggy

Company Prunty Production

Stoltenberg Pool

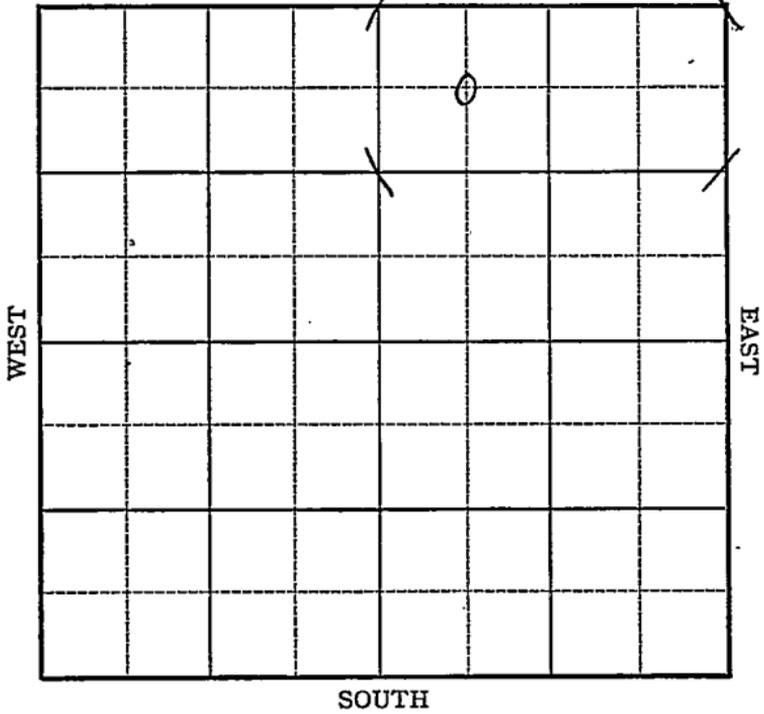

2

KANSAS

Ellsworth

Sec. 20 Twp. 16 R. 10-W

Well No. #1 Haggy Farm
Prunty Production Company

Stoltenberg Pool


660 Ft. from N. Line

_____ Ft. from S. Line

_____ Ft. from E. Line

660 Ft. from W. Line

C NW NE Elev. 1861

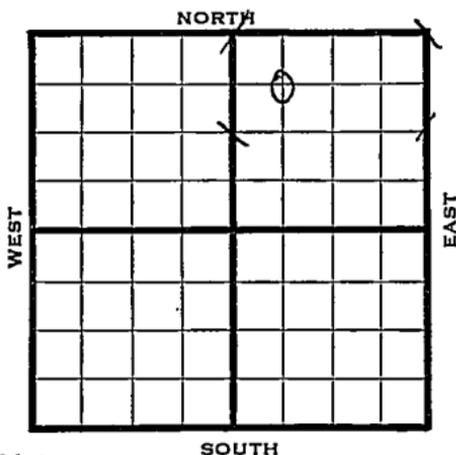

1942

REPORT

11/18

Spud

11/24

"

12/2

Lans 3023

Drig. 3305

12/9

Arb. 3353

Water

T.D. 3359

ABANDONED

KANSAS

Map No. 55 Sec. 20 Twp. 16 R. 10W

Well No. 1 Haggy

Prunty Production Company

FIRST REPORT Contractor

C NW NE


SECTION PLAT

660 Ft. from N. Line

_____ Ft. from S. Line

_____ Ft. from E. Line

660 Ft. from W. Line

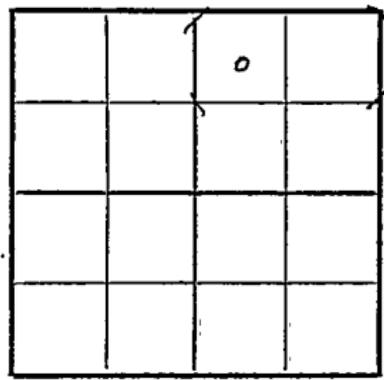

STOLTENBERG POOL

Location _____

Rig up _____

Drilling and Remarks:

Spud

RECORD

Cased _____ in., _____ ft.

Sand _____

Gas _____

Oil _____

Total Depth _____

PRODUCTION

1st 24 hrs. Nat. _____

1st 24 hrs. after shot _____

Gas _____ Cu. Ft.

Dry Hole _____

Abandoned _____

Date

NOV 18 1942 19

S. J. LEWIS Scout

Map No. 55 Sec. 20 Twp. 16 R. 10WWell No. 1 HaggyPrunty Production CompanyABANDONED Contractor

C NW NE

660 Ft. from N. Line

_____ Ft. from S. Line

_____ Ft. from E. Line

660 Ft. from W. Line

SECTION PLAT

		o	

STOLTENBERG POOL

Location _____

Rig up _____

Drilling and Remarks:

*Cr 83353**Water*

RECORD

Cased _____ in., _____ ft.

Sand _____

Gas _____

Oil _____

Total Depth 3309

PRODUCTION

1st 24 hrs. Nat. _____

1st 24 hrs. after shot _____

Gas _____ Cu. Ft.

Dry Hole _____

Abandoned _____

Date

DEC 9 1942 19S. J. LEWIS Scout