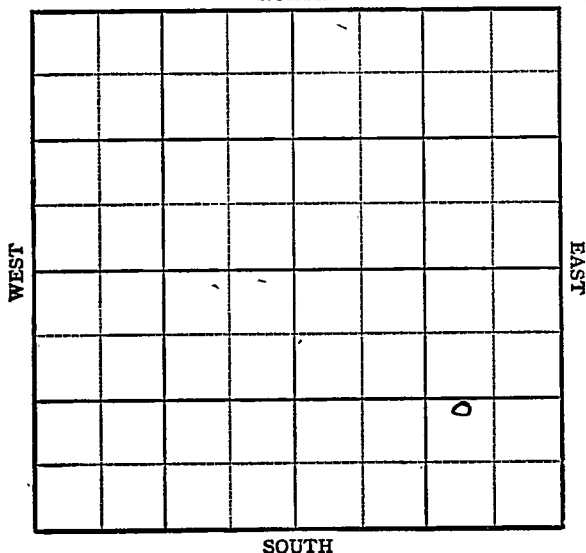


Section 20 Township 16 Range 10WWell No. 5 LanglCompany H.V. ElwellStoltenberg Pool
NORTH

Sec. 20 Twp. 16 R. 10W ☒

Well No. 5 Langl Farm

H.V. Elwell Company

Stoltenberg Pool


 Ft. from N. Line

1270 Ft. from S. Line

870 Ft. from E. Line

 Ft. from W. Line

NW SE SE

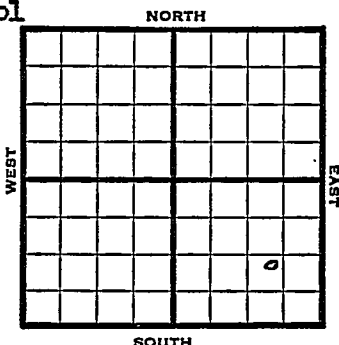

1948 Eli 1844' REPORT

11/17	Location
11/23	10" @ 374'
11/30	Drlg 2600'
12/8	Arb. 3329'
	Drlg 3545
	SWD
12/14	Lansing 2998'
	Granite 3761
	7" @ 3332'
	TD 3762'
12/22	"
12/29	TD 3762'
	Cong 3309'
	Arb. 3329'
	Granite 3761'
	SWD
	Aband.
	ABANDONED

Map No. _____ Sec. 20 Twp. 16 R. 10W

Well No. 5 Langl

H. V. Elwell Company

FIRST REPORT

Contractor

NW SE SE

SECTION PLAT

_____ Ft. from N. Line

1270 Ft. from S. Line

870 Ft. from E. Line

_____ Ft. from W. Line

			a

Ellsworth County

Location X

Rig up _____

Drilling and Remarks:

RECORD

Cased _____ in., _____ ft.

Sand _____

Gas _____

Oil _____

Total Depth _____

PRODUCTION

1st 24 hrs. Nat. _____

1st 24 hrs. after shot _____

Gas _____ Cu. Ft.

Dry Hole _____

Abandoned _____

Date

NOV 17 1948 19

S. J. LEWIS

Scout


Map No. 55 Sec. 20 Twp. 16 R. 10WWell No. 5 LanglH. V. Elwell Company**ABANDONED**

Contractor

NW SE SE

E 11874
SECTION PLAT Ft. from N. Line1270 Ft. from S. Line870 Ft. from E. Line Ft. from W. Line

Ellsworth County

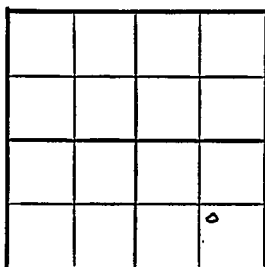Location Rig up Drilling and Remarks: Core 3309Core 43329Granite 3261BWD**RECORD**Cased in., ft.Sand Gas Oil Total Depth 3262**PRODUCTION**1st 24 hrs. Nat. 1st 24 hrs. after shot Gas Cu. Ft.Dry Hole Abandoned

Date

DEC 29 194819S. J. LEWIS Scout