

*Ind*

STATE CORPORATION COMMISSION OF KANSAS  
OIL & GAS CONSERVATION DIVISION

WELL COMPLETION OR RECOMPLETION FORM  
ACO-1 WELL HISTORY

DESCRIPTION OF WELL AND LEASE

Operator: License # 6113  
Name Landmark Oil Exploration, Inc.  
Address 105 S. Broadway, Suite 1040  
City/State/Zip Wichita, Kansas 67202

Purchaser None

Operator Contact Person Jeff Wood  
Phone (316) 265-8181

Contractor: License # 6033  
Name Murfin Drilling Company

Wellsite Geologist Tim Legge  
Phone (316) 682-8121

Designate Type of Completion

- New Well     Re-Entry     Workover
- Oil     SWD     Temp Abd
- Gas     Inj     Delayed Comp.
- Dry     Other (Core, Water Supply etc.)

If OWWO: old well info as follows:

Operator  
Well Name  
Comp. Date ..... Old Total Depth.....

WELL HISTORY

Drilling Method:  
 Mud Rotary     Air Rotary     Cable  
3-21-86                      3-28-86                      3-28-86  
.....  
Spud Date                      Date Reached TD                      Completion Date  
4330'  
.....  
Total Depth                      PBD

Amount of Surface Pipe Set and Cemented at 250 feet  
Multiple Stage Cementing Collar Used?  Yes  No  
If yes, show depth set.....feet  
If alternate 2 completion, cement circulated  
from.....feet depth to.....w/.....SX cmt

API NO. 15-063-21-025

County Gove  
150' N of  
SE NE NE Sec. 9 Twp. 15S Rge. 27  East  West

4440 Ft North from Southeast Corner of Section  
330 Ft West from Southeast Corner of Section  
(Note: Locate well in section plat below)


Lease Name Albin "A" Well # 1-9

Field Name

Producing Formation None

Elevation: Ground 2455' KB 2460'

Section Plat

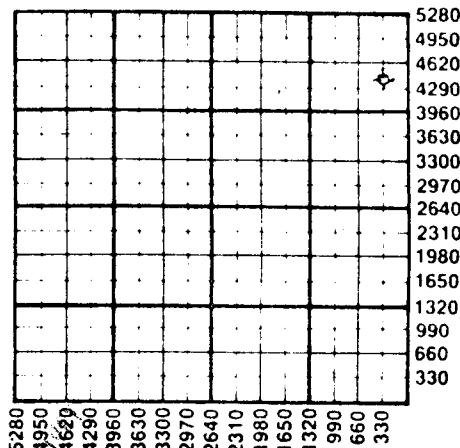

WATER SUPPLY INFORMATION

Disposition of Produced Water:  Disposal  Repressuring  
Docket #

Questions on this portion of the ACO-1 call:  
Water Resources Board (913) 296-3717

Source of Water:  
Division of Water Resources Permit #

Groundwater.....Ft North from Southeast Corner (Well) .....Ft West from Southeast Corner of Sec Twp Rge  East  West

Surface Water.....Ft North from Southeast Corner (Stream, pond etc).....Ft West from Southeast Corner Sec Twp Rge  East  West

Other (explain) Purchased from Jeff Bernbeck (purchased from city, R.W.D. #)

INSTRUCTIONS: This form shall be completed in duplicate and filed with the Kansas Corporation Commission, 200 Colorado Derby Building, Wichita, Kansas 67202, within 90 days after completion or recompletion of any well. Rule 82-3-130 and 82-3-107 apply.

Information on side two of this form will be held confidential for a period of 12 months if requested in writing and submitted with the form. See rule 82-3-107 for confidentiality in excess of 12 months. One copy of all wireline logs and drillers time log shall be attached with this form. Submit CP-4 form with all plugged wells. Submit CP-111 form with all temporarily abandoned wells.