



Sec. 29 Twp. 25 R. 4E ✓

Well No. #2 Johnson Farm

E. Adair Company


Wildcat

1320' Ft. from N. Line

\_\_\_\_\_ Ft. from S. Line

\_\_\_\_\_ Ft. from E. Line

990' Ft. from W. Line

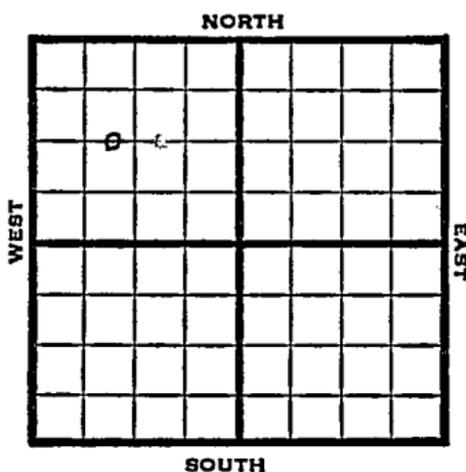

C E L  $W\frac{1}{2}$  NW

1949

Elev 1330'

REPORT

5/4 Machine

5/10 Drlg. 170'

5/18 Drlg 1400'

5/25 Drlg. 1540'

6/1 "

6/8 Miss 2550'

Viola 2672'

TD 2702'

Aband.

**ABANDONED**

Kansas

Map No. \_\_\_\_\_ Sec. 29 Twp. 25 R. 4EWell No. 2 JohnsonE. Adair Company

## FIRST REPORT

Contractor


C E L.  $W\frac{1}{2}$  NW

## SECTION PLAT

1320 Ft. from N. Line

\_\_\_\_\_ Ft. from S. Line

\_\_\_\_\_ Ft. from E. Line

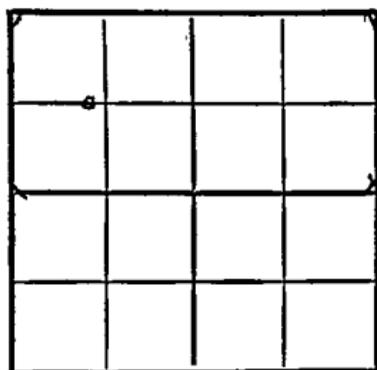990 Ft. from W. Line

Butler County

## RECORD

Location \_\_\_\_\_

Cased \_\_\_\_\_ in., \_\_\_\_\_ ft.

Rig up \_\_\_\_\_

Sand \_\_\_\_\_

Drilling and Remarks:

Gas \_\_\_\_\_

Machine \_\_\_\_\_

Oil \_\_\_\_\_

Total Depth \_\_\_\_\_

## PRODUCTION

1st 24 hrs. Nat. \_\_\_\_\_

1st 24 hrs. after shot \_\_\_\_\_

Gas \_\_\_\_\_ Cu. Ft.

Dry Hole \_\_\_\_\_

Abandoned \_\_\_\_\_

Date

MAY 4 1949

19

S. J. LEWIS

Scout

Butler County Kansas State

Map No. K 14 Sec. 29 Twp. 25 R. 4E

Well No. 2 Johnson

E. Adair Company

**ABANDONED**

Contractor

C E L  $W\frac{1}{2}$  NW

E. 1230  
SECTION PLAT

1320 Ft. from N. Line

\_\_\_\_\_ Ft. from S. Line

\_\_\_\_\_ Ft. from E. Line

990 Ft. from W. Line


Wildcat

Remarks:

*Misc 2550*

*Vista 2672*

*JTD 2702*

Date  
JUN 8 1949

Scout  
S. J. LEWIS