


Section 3 Township 32 Range 7 E

Well No. # 3 Barger

Company Helmerich & Payne

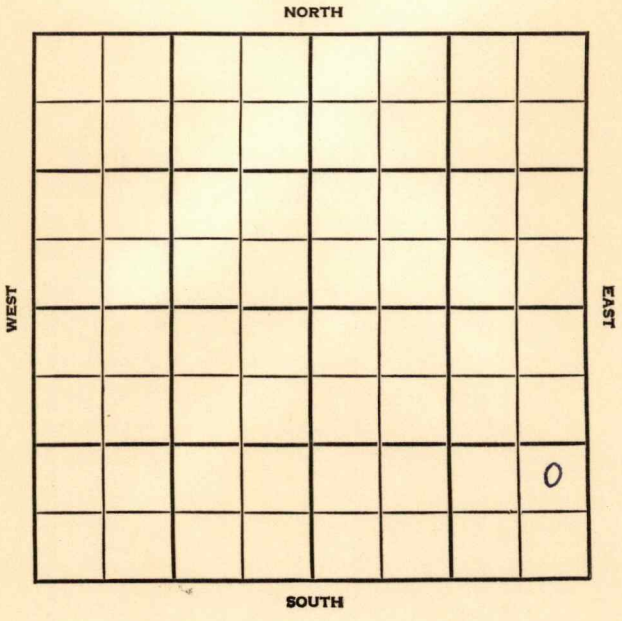

Cowley

KANSAS

SEC.	3	TWP.	32	R.	7E
------	---	------	----	----	----


WELL NO. #3 Barger FARM

COMPANY Helmerich & Payne

CONTRACTOR

N. School Creek Pool

_____ Ft. from N. Line
 990 _____ Ft. from S. Line
 330 _____ Ft. from E. Line
 _____ Ft. from W. Line

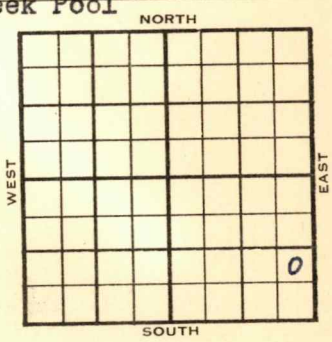

NE SE SE

	ELEVATION	REPORT
1954	1416'	

12/22 Cellar & Pits.
 1955
 2/2 Spud 1-3-55 Oil well TD 2480
 10" @ 115 Stal. 1703 Layton 2137
 Cleve. 2412 TD 2480 7" @ 2480
 CO to 2200 60/2136-52 S/20 BOPH
 Comp. 25 BOPD

COMPLETED

