


Section 3 Township 32 Range 7 E

Well No. # 4 Barger

Company Helmerich & Payne

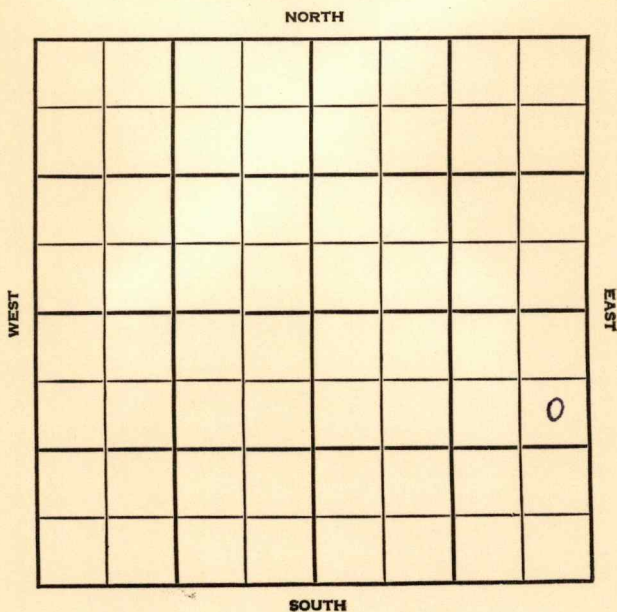

Cowley

KANSAS

SEC.	TWP.	R.
3	32	7E

WELL NO. #4 Barger FARM

COMPANY Helmerich & Payne

CONTRACTOR McKnab & Lindsay


N. School Creek Pool NORTH

990 Ft. from N. Line

Ft. from S. Line

330 Ft. from E. Line

Ft. from W. Line

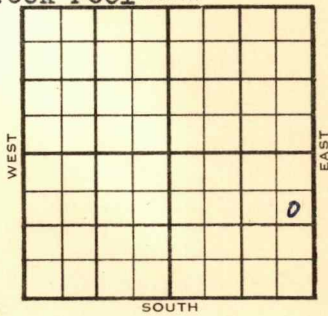

SE NE SE

1954	ELEVATION	REPORT
	1415'	

12/22 Location

1955
2/9

Spud 1-8-55 Oil well TD 2485
 10" @ 112 Stal. 1716 Layton 2135
 Cleve 2406 TD 2485 5" @ 2484
 24/2146-70 frac F/30 BOPH
 Comp. 25 BOPD
COMPLETED

County Cowley State Kan

Sec. 3 (Blk. Twp.) 32 (Sur. Rge.) 7E Map No.

Operator Helmerich & Payne

Well No. 4 Farm Barger

Elev. 1415 Location SE NE SE

990 Ft. From N Line SE

330 Ft. From E Line Quarter

1st. Report

Completion FEB 9 1955

Remarks N. School Creek Pool

McKnab & Lindsay - Contr

Spudding Date 1-8-55

Drlg. Data Oil well TD 2485

10" @ 112 Stal. 1716 Layton 2135

Cleve. 2406 TD 2485 5" @ 2484

24/ 2146-70 frac F/ 30 boph

Comp. 25 bopd

FABEN GILSTRAL