


DX 78-1

Cowley KANSAS

Section 3 Township 32 Range 7E

Well No. 6 Barger

Company Helmerich & Payne

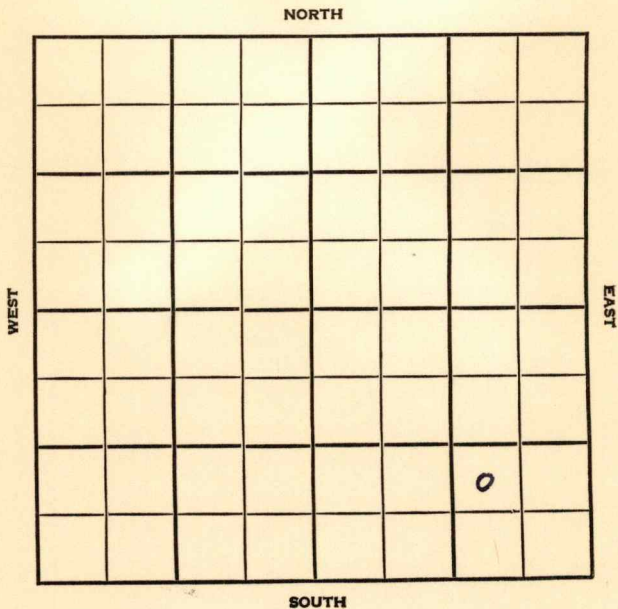

Cowley

KANSAS

SEC.	TWP.	R.
3	32	7E


WELL NO. #6 Barger FARM

COMPANY Helmerich & Payne

CONTRACTOR McKnab & Lindsay

N. School Creek ^N ~~Boal~~

_____ Ft. from N. Line
 990 _____ Ft. from S. Line
 990 _____ Ft. from E. Line
 _____ Ft. from W. Line

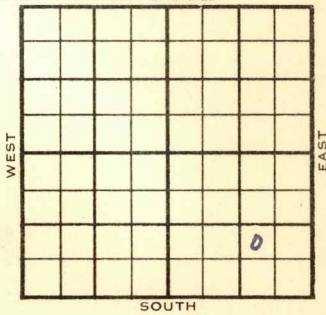

NW SE SE

1955	ELEVATION	REPORT
	1408'	

1/19 Location
 2/9 Oil well TD 2230 TD 2230 5" @ 222
 120/2140-60 Layton 2130 frac.
 F/20 BOPH 1 hr. Comp. 25 BOPD

COMPLETED

