


Section 3 Township 32 Range 7 E

Well No. # 8 Barger

Company Helmerich & Payne

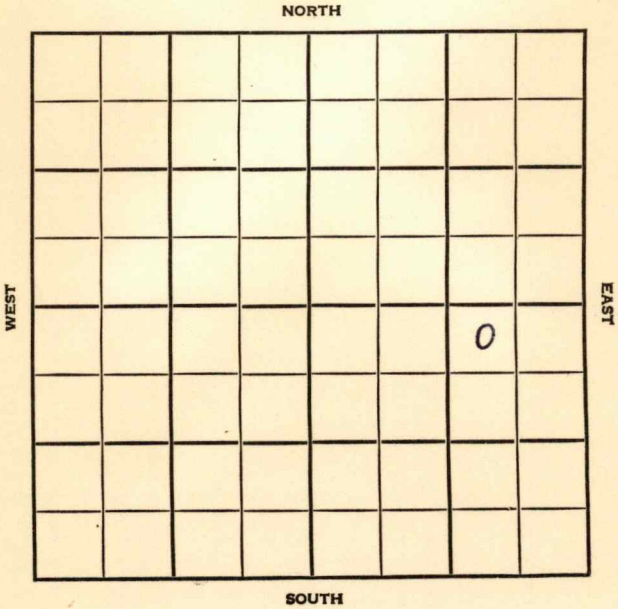

SEC. 3	TWP. 32	R. 7E
-----------	------------	----------

WELL NO. #8 Barger FARM

COMPANY Helmerich & Payne

CONTRACTOR McKnab & Lindsay


School Creek Pool

330 Ft. from N. Line

Ft. from S. Line

990 Ft. from E. Line

Ft. from W. Line

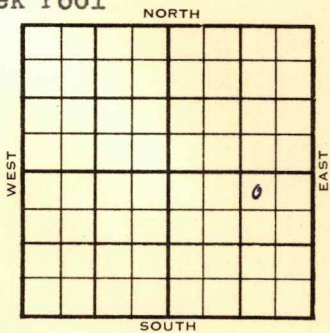

NW NE SE

1955	ELEVATION 1413'	REPORT
------	--------------------	--------

2/2 Spud 1-27-55
8" @ 132'
Drlg. 1760'

2/9 Spud 1-27-55 Oil well TD 2232
8" @ 132 Layton 2137 TD 2232
5" @ 2230 90/2146-61 frac.
F/115 BO 11 hr.
Comp. 25 BOPD

COMPLETED

