


Section 31 Township 25 Range 4 E

Well No. # 1 Grace

Company Rex & Morris

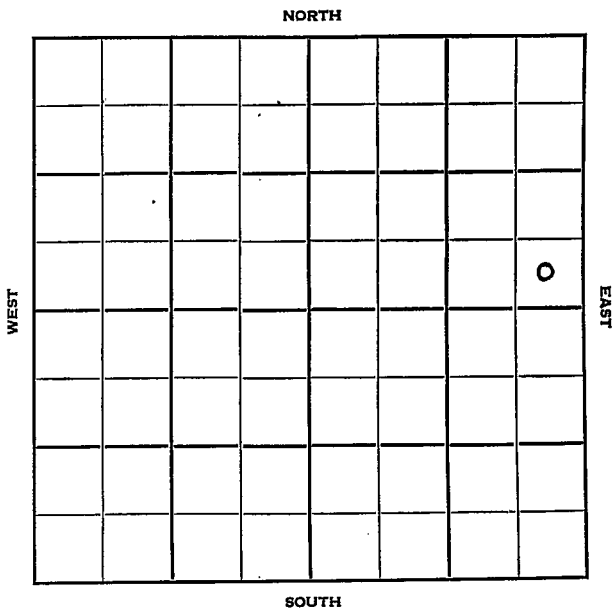

Butler
25

KANSAS
R. 4E

Sec. 31 Twp.

Well No. #1 Grace Farm

Rex & Morris Company

Contractor


_____ Ft. from N. Line

330' Ft. from S. Line

330' Ft. from E. Line

_____ Ft. from W. Line

SE SE NE

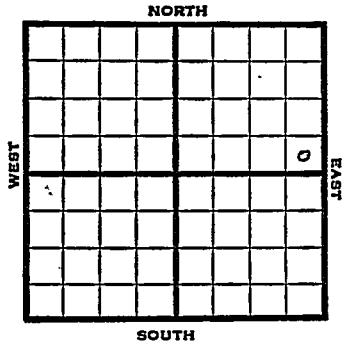

1951 Elev. 1280' REPORT

3/14
4/18

RUR
 Spud 3-16-51
 D&A TD 2637
 15" @ 145 10" @ 1573
 Lans. 1795
 8" @ 2200 Cong. 2490
 Chat 2500 Miss 2525
 TD 2637
 D&A

ABANDONED

