


DX 78-1

Cowley KANSAS

Section 3 Township 32 Range 7E

Well No. 5 Barger

Company Helmerich & Payne

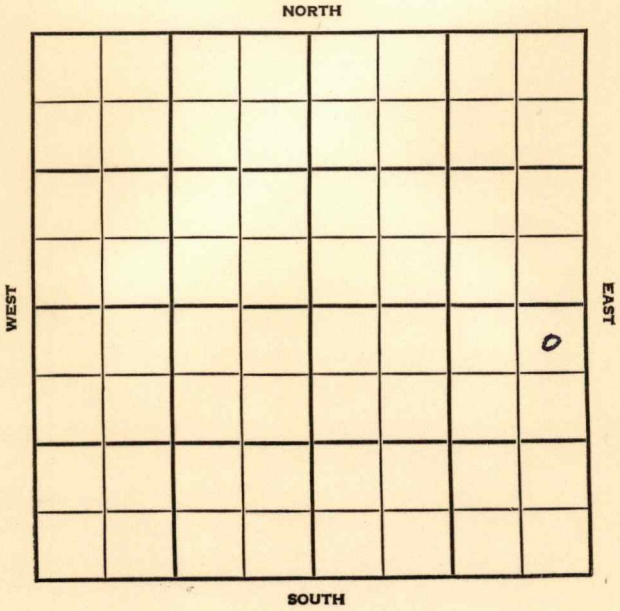

Cowley

KANSAS

SEC.	TWP.	R.
3	32	7E

WELL NO. #5 Barger FARM

COMPANY Helmerich & Payne

CONTRACTOR McKnab & Lindsay


N. School Creek Pool NORTH

330 Ft. from N. Line

Ft. from S. Line

330 Ft. from E. Line

Ft. from W. Line

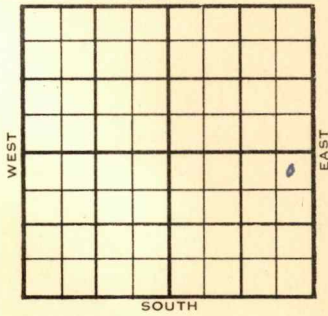

NE NE SE

	ELEVATION	REPORT
1955	1419'	

1/19 M I R

2/9 Spud 1-19-55 Oil well TD 2239  
 8" @ 111 Layton 2110 TD 2239  
 5" @ 2236 CO 120/2148-68 frac.  
 F/120 BO 1 hr. F/35 BO 1 hr.  
 Comp. 25 BOPD

**COMPLETED**



