

Cowley


DX 78-1

KANSAS

Section 3 Township 32 Range 7E

Well No. #11 Barger

Company Helmerich & Payne

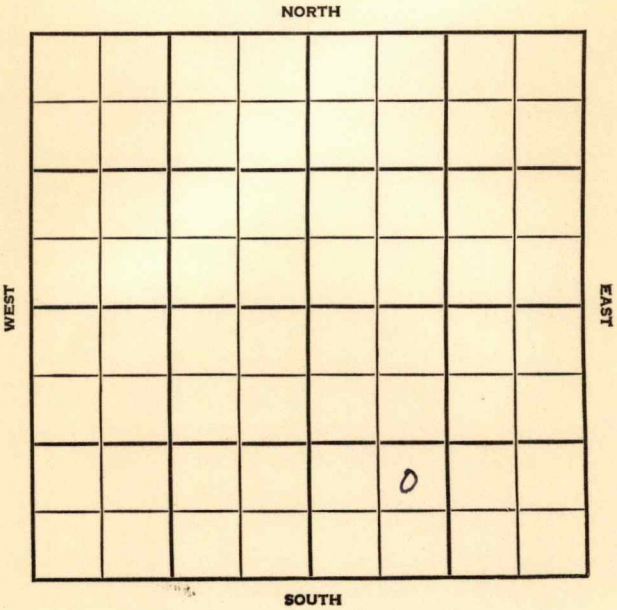

Cowley

SEC. TWP. R.

3

32

7E

WELL NO.

#11 Barger

FARM

COMPANY

Helmerich & Payne

CONTRACTOR

McKnab & Lindsay

School Creek Pool

Ft. from N. Line

990


Ft. from S. Line

Ft. from E. Line

990

Ft. from W. Line

NE SW SE

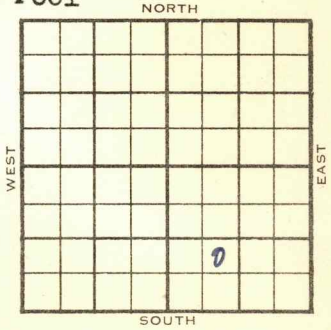

ELEVATION REPORT

1955

4/6

Spud 4-3-55
8" @ 107'
Drlg. 1150'

