

Ellsworth County

Bloomer Pool


FORM 51 10M 12-46 PETROL

KANSAS

Section 20 Township 16 Range 10W

Well No. 2 Lanzl

Company H. V. Elwell

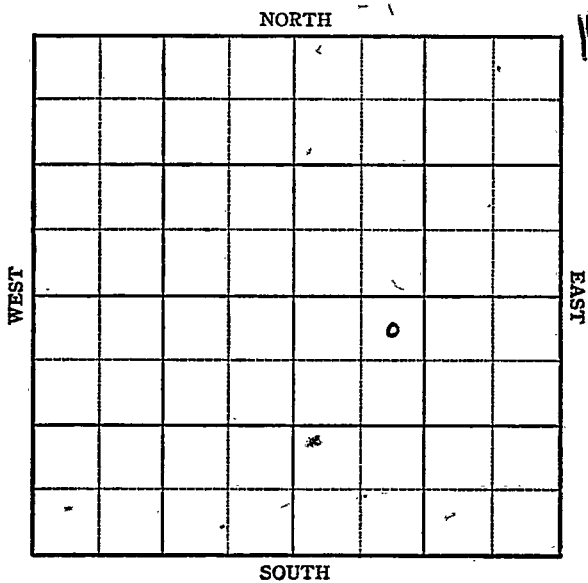

KANSAS

Ellsworth

Sec. 20 Twp. 16 R. 10-W

Well No. #2 Lanzl Farm

H. V. Elwell Company


Bloomer Pool

330 Ft. from N. Line

Ft. from S. Line

Ft. from E. Line

990 Ft. from W. Line

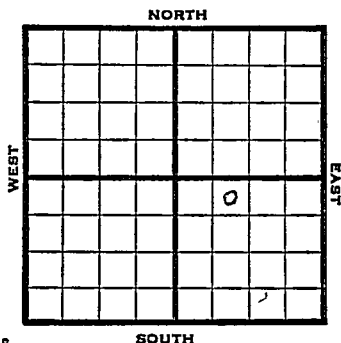

NE NW SE Elev. 1850'

REPORT

1947

2/26 Drlg 380'

3/4 10" @ 370'
Drlg 2435'

3/11 Arb 3302-05
TD 3305'
7" @ 3304'
RUST

3/18 TD 3305'
RUST

3/25 TD 3330'
PB

4/2 TD 3337'
Csg. 3260'
10 shots 3175'-80' no shows.

4/1 " " "

4/15 " " "

4/23 " " "

4/29 " " "

5/7 " " "

OVER

5/13	TD 3337'
5/20	" "
5/27	" "
6/3	" "
6/10	" "
6/17	" "
6/24	" "
7/1	" "
7/8	" "
7-16	" "
7/22	" "
7/30	Arb. 3302' 7" @ 3304' Pump 18 Oil / 80W pot. 43.0 Gr. TD 3337'

COMPLETED

Map No. 55 Sec. 20 Twp. 16 R. 10WWell No. 2 LanzlH. V. Elwell

Company

FIRST REPORT

Contractor

NE NW SE

SECTION PLAT

		2	

330 Ft. from N. Line Ft. from S. Line Ft. from E. Line990 Ft. from W. LineEllsworth CountyLocation Rig up

Drilling and Remarks:

drlg. 380'

RECORD

Cased in., ft.Sand Gas Oil Total Depth

PRODUCTION

1st 24 hrs. Nat. 1st 24 hrs. after shot Gas Cu. Ft.Dry Hole Abandoned

Date

FEB 26 1947 19S. J. LEWIS

Scout

Map No. 55 ^{Kansas} Sec. 20 Twp. 16 R. 10W

Well No. 2 Lanzl

H. V. Elwell Company

COMPLETE

NE NW SE

Contractor


E 11830
SECTION PLAT

330 Ft. from N. Line

 Ft. from S. Line

 Ft. from E. Line

990 Ft. from W. Line

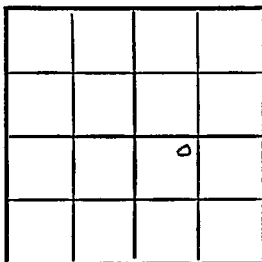

Ellsworth County

RECORD

Location

Rig up

Drilling and Remarks:

Cased in., ft.

Sand

Gas

Oil

Total Depth 3332

PRODUCTION

1st 24 hrs. Nat.

1st 24 hrs. after shot

Gas Cu. Ft.

Dry Hole

Abandoned

Date

JUL 30 1947 19

S. J. LEWIS

Scout