


Section 20 Township 16- Range 10-W

Well No. #3 Lanzl

Company H. V. Elwell

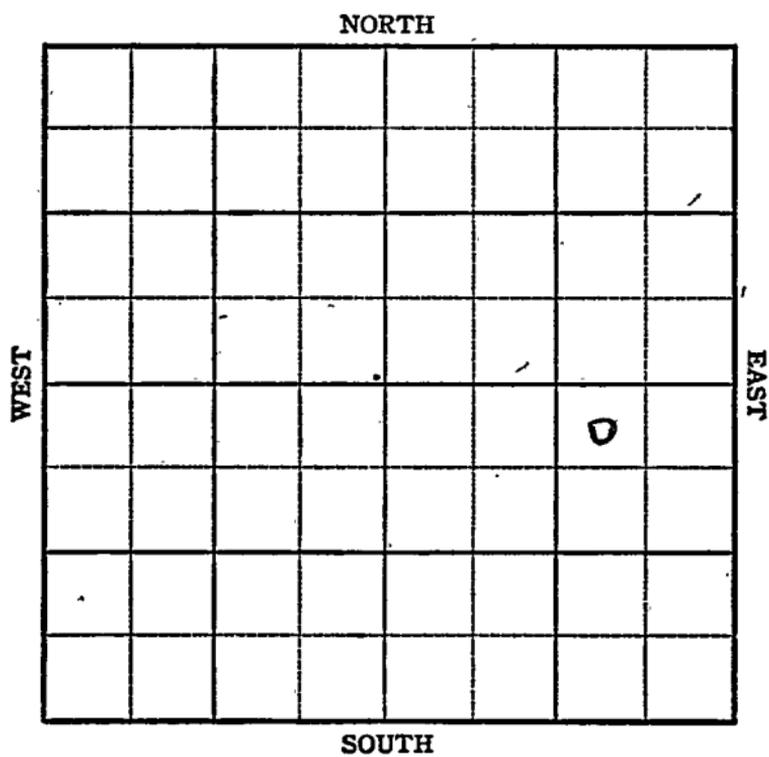

Sec. 20 Twp. 16 R. 10-W

Well No. #3 Lanzl Farm


H. V. Elwell Company  
Bloomer Pool

330 Ft. from N. Line

\_\_\_\_\_ Ft. from S. Line

990 Ft. from E. Line

\_\_\_\_\_ Ft. from W. Line

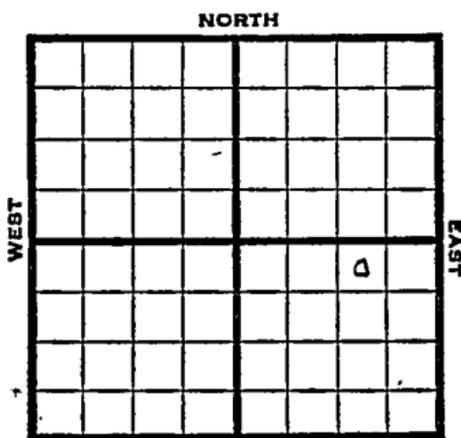

Elev. m 1848'

NW NE SE

REPORT

1947

3/12 Location

3/18 Drlg 125'

3/25 10" @ 370'  
Drlg 2510'

4/2 Arbuckle 3310' - 15' TD  
5" @ 3313'  
RUST

4/9 Swb 1 bbl oil PH 4 hrs

4/15 500 Acids  
Shot 20 bbls. oil PH

4/23 " " "

4/29 " " "

5/7 " " "

5/14 Arb. 3310'  
5" @ 3313'  
500 Acid  
Pump 100 Pot  
42.0 Gr.  
TD 3315'

COMPLETED

Kansas

Map No. 55 Sec. 20 Twp. 16 R. 10W

Well No. 3 Lanzl

H. V. Elwell Company

FIRST REPORT Contractor

NW NE SE

SECTION PLAT

330 Ft. from N. Line

\_\_\_\_\_ Ft. from S. Line

990 Ft. from E. Line

\_\_\_\_\_ Ft. from W. Line

			Δ

Ellsworth County

Location X

Rig up \_\_\_\_\_

Drilling and Remarks:

RECORD

Cased \_\_\_\_\_ in., \_\_\_\_\_ ft.

Sand \_\_\_\_\_

Gas \_\_\_\_\_

Oil \_\_\_\_\_

Total Depth \_\_\_\_\_

PRODUCTION

1st 24 hrs. Nat. \_\_\_\_\_

1st 24 hrs. after shot \_\_\_\_\_

Gas \_\_\_\_\_ Cu. Ft.

Dry Hole \_\_\_\_\_

Abandoned \_\_\_\_\_

Date

MAR 12 1947 19

S. J. LEWIS Scout

Bloomer Pool

Map No. 755 Sec. 20 Twp. 16 R. 10<sup>W</sup>

Well No. 3 Lantz

H. V. Elwell Company

**COMPLETE**

Contractor

NW NE SE

*E 11848*  
SECTION PLAT

330 Ft. from N. Line

\_\_\_\_\_ Ft. from S. Line

990 Ft. from E. Line

\_\_\_\_\_ Ft. from W. Line

			0

Ellsworth County

Location \_\_\_\_\_

Rig up \_\_\_\_\_

Drilling and Remarks:

*Cr 3310  
5" @ 3313  
500 Diesel  
Pump 100 Bt*

*42. 2/11*

**RECORD**

Cased \_\_\_\_\_ in., \_\_\_\_\_ ft.

Sand \_\_\_\_\_

Gas \_\_\_\_\_

Oil \_\_\_\_\_

Total Depth 3310

**PRODUCTION**

1st 24 hrs. Nat. \_\_\_\_\_

1st 24 hrs. after shot \_\_\_\_\_

Gas \_\_\_\_\_ Cu. Ft.

Dry Hole \_\_\_\_\_

Abandoned \_\_\_\_\_

Date

MAY 14 1947 19

S. J. LEWIS Scout