

Cowley

KANSAS

SEC. <div style="text-align: center; font-size: 24px;">5</div>	TWP. <div style="text-align: center; font-size: 24px;">32</div>	R. <div style="text-align: center; font-size: 24px;">6E</div>
---	--	--

WELL NO. FARM
#1 Lauppe

COMPANY
Johnson & Gill

CONTRACTOR
Wakefield.


Wildcat.

_____ Ft. from N. Line
990 _____ Ft. from S. Line

_____ Ft. from E. Line

330 _____ Ft. from W. Line

NW SW SW

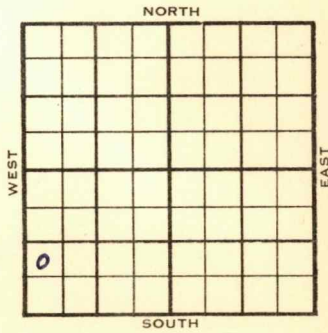

	ELEVATION	REPORT
1954	1366'	

12/22 Spud 12-17-54
 8" @ 135'
 Drlg. 2017'

1955
 1/12 Spud 12-17-54 D & A TD 3145
 8" @ 135 **KC 2458 Stal. 1960**
Miss. 3126 TD 3145 D & A

ABANDONED

