


Section 6 Township 32 Range 6 E

Well No. # 1 Aker

Company Murfin et al

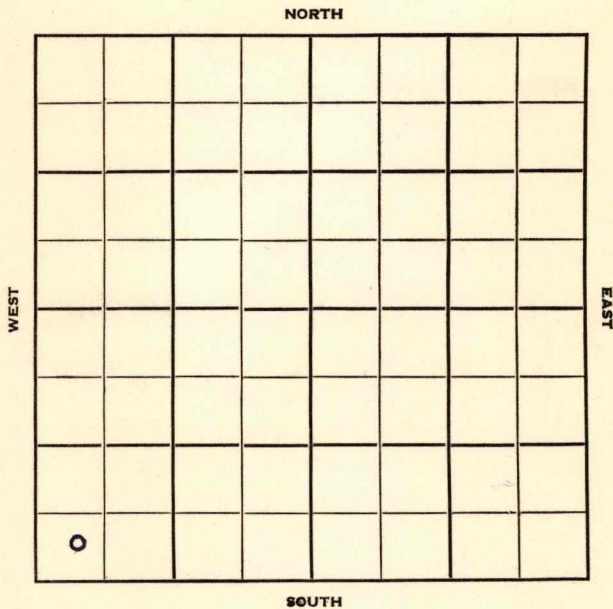

Sec. 6 Twp. 32 R. 6E

Well No. #1 Aker Farm

Murfin et al Company

Murfin - Contr. Contractor

Wildcat


 Ft. from N. Line

330' Ft. from S. Line

 Ft. from E. Line

430' Ft. from W. Line

SW SW SW

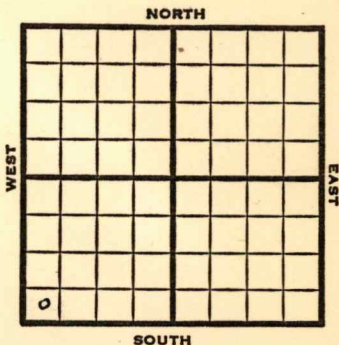

1951

Elv. 1343' REPORT

3/21
5/16

RUR
Spud 3-30-51
D&A TD 2350
12" @ 814' 10" @ 1720
8" @ 1780
Sand 2290
TD 2350 D&A

ABANDONED

