


Ellsworth KANSAS

Section 21 Township 16 Range 10-W

Well No. #1 Boldt

Company Skelly Oil

NORTH Stoltenberg Pool

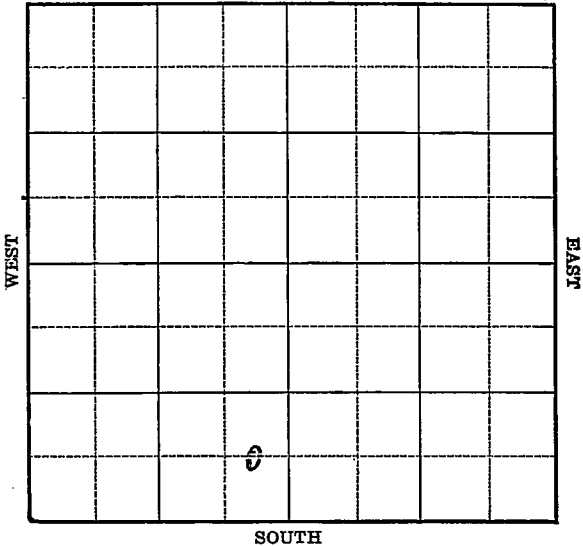

[illegible]

Map No. _____ Sec. 21 Twp. 16 R. 10WWell No. 1 BoldtSkelly Oil

Company _____

Contractor _____

FIRST REPORTC E L SE SW

Ft. from N. Line

660

Ft. from S. Line

330

Ft. from E. Line

Ft. from W. Line

STOLTENBERG POOL**SECTION PLAT**

Location _____

Rig up _____

Drilling and Remarks:

Rotary**RECORD**

Cased _____ in., _____ ft.

Sand _____

Gas _____

Oil _____

Total Depth _____

PRODUCTION

1st 24 hrs. Nat. _____

1st 24 hrs. after shot _____

Gas _____ Cu. Ft.

Dry Hole _____

Abandoned _____

Date

JUL 24 1940 19S. J. LEWIS Scout

Map No. _____ Sec. 21 Twp. 16 R. 10WWell No. 1 Boldt

Skelly Oil

Company

Contractor

ABANDONED

C E L SE SW

_____ Ft. from N. Line

660 Ft. from S. Line330 Ft. from E. Line

_____ Ft. from W. Line

STOLTENBERG POOL

SECTION PLAT

Location _____

Rig up _____

Drilling and Remarks:

*Cur 83326.**4" @ 8327.**1000 acid**Pump 29 oil 43 Water**24 hrs.*

RECORD

Cased _____ in., _____ ft.

Sand _____

Gas _____

Oil _____

Total Depth 3339

PRODUCTION

1st 24 hrs. Nat. _____

1st 24 hrs. after shot _____

Gas _____ Cu. Ft.

Dry Hole _____

Abandoned _____

Date

SEP 4 1940 19

S. J. LEWIS Scout