


Section 3 Township 32 Range 7E

Well No. #12 Barger

Company Helmerich & Payne

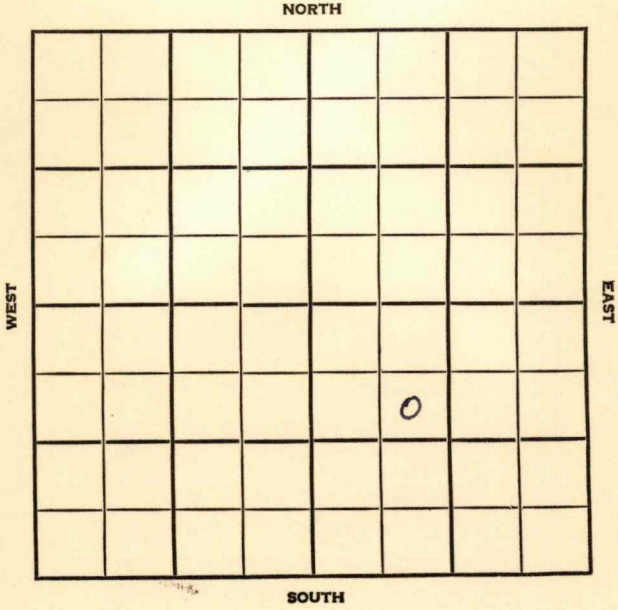

Cowley

KANSAS

SEC.	TWP.	R.
3	32	7E

WELL NO. #12 Barger FARM

COMPANY Helmerich & Payne


CONTRACTOR McKnab & Lindsay
School Creek Pool

990 Ft. from N. Line

Ft. from S. Line

Ft. from E. Line

990 Ft. from W. Line

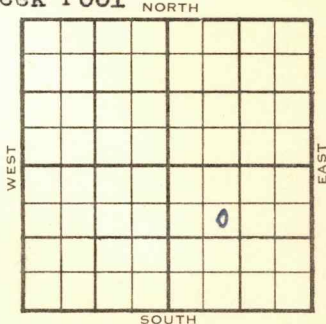

SE NW SE

1955

ELEVATION

REPORT

4/6

C & P

