


Section 3 Township 32 Range 7E

Well No. #13 Barger

Company Helmerich & Payne

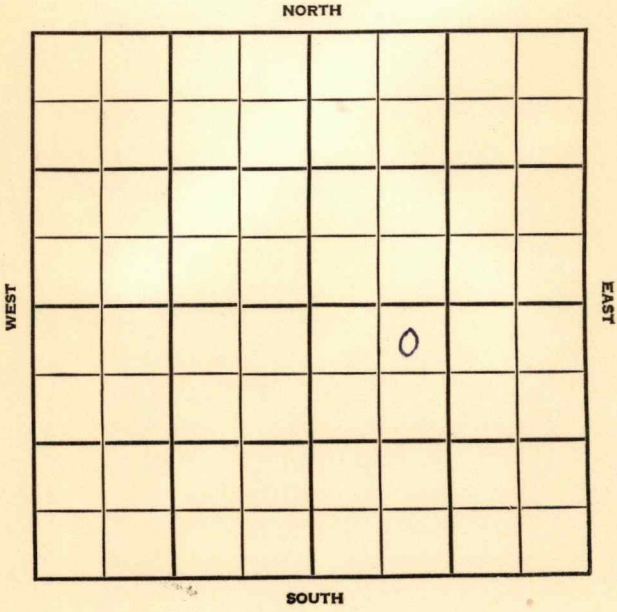

Cowley

KANSAS

SEC.	TWP.	R.
3	32	7E

WELL NO.

#13 Barger

FARM

COMPANY

Helmerich & Payne

CONTRACTOR

McKnab & Lindsay

School Creek PoolTH


330 Ft. from N. Line

Ft. from S. Line

Ft. from E. Line

990 Ft. from W. Line

NE NW SE

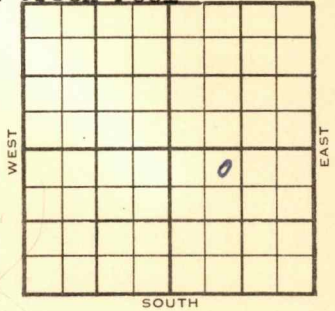

1955	ELEVATION	REPORT
	1405' RB	1403' DF

4/13 M I R

6/8
 Comm 4-12-55
 Anh Stal 1750-1833
 TP Layton 2130-2214
 8 5/8" @ 120/120
 5 1/2" @ 2242/125 60/2150-65
 frac wtr CO to 2172, 24/2150-66
 frac S/3 bo 15 bwph
 Comp 25 bopd

COMPLETED

County **Cowley** State **Kansas**

Sec. **3** (Blk.) **32** (Sur.) **7E** Map No.

Operator **Helmerich & Payne**

Well No. **13** Farm **Barger**

Elev. **1405 RB** Location **NE NW SE**

FIRST REPORT

330 Ft. From **N** Line **SE**

990 Ft. From **W** Line Quarter

1st. Report **APR 13 1955**

Completion

Remarks

McKnab & Lindsay - Contr.

Spudding Date

Drlg. Data **School Creek Pool**

M I R

County Cowley ✓ Elev. 1403
 Sec. 3 Twp. 32 Rge. 7E
 Company Helmerich & Payne
 Farm Name Barger No. 13

	TOPS	DEPTH	LOG	DATUM
Anh.	<u>Stal</u>	<u>17.50</u>	<u>1833</u>	<u>347</u>
Tp.	<u>Layton</u>	<u>2130</u>	<u>2214</u>	<u>727</u>
H.				
Tr.				
Dg.				
Bl.				
L.				
K.C.				
B.K.C.				
Ce.				
C.				
M.				
M.				
K.				
Mz.				
Me.				
V.				
S.				
S.				
A.				
R.				
PE.				
G.				
T.D.		<u>2243</u>		

Loc. in Sec. NE NW SE
 Geol. _____
 Contr. _____
 McKnab & Lindsay
 Pool School Creek

COMPLETE
 JUN 8 '55

Date Comm. 4-12-55
8 5/8" @ 120/120 5 1/2" @ 2242/125
60/ 2150-65 frac wtr. CO to 2172
24/ 2150-66 frac S/ 3 bo 15 bwph
 Comp. 25 bopd

Co.
 Lse.
 No.
 Sec.
 T.
 R.