


Section 4 Township 32 Range 7 E

Well No. # 1 Redford

Company Fred Ayesh

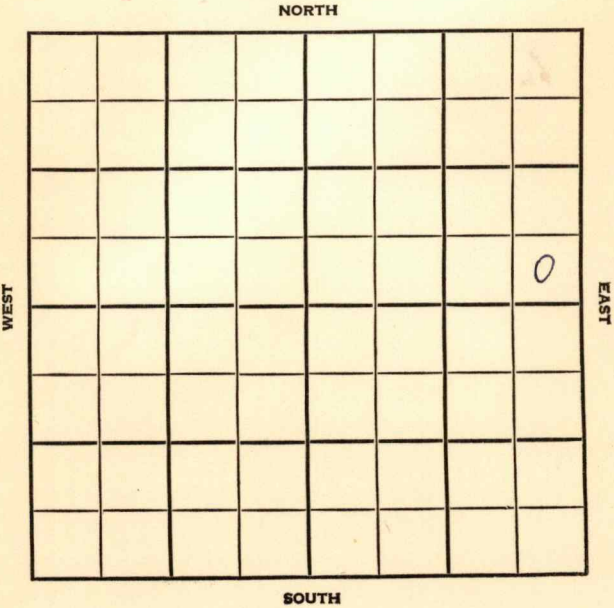

Cowley KANSAS

SEC.	TWP.	R.
4	32	7E

WELL NO. 1 Redford FARM

COMPANY Fred Ayesh

CONTRACTOR Kriswell Tools


Wildcat

_____ Ft. from N. Line

330 _____ Ft. from S. Line

330 _____ Ft. from E. Line

_____ Ft. from W. Line

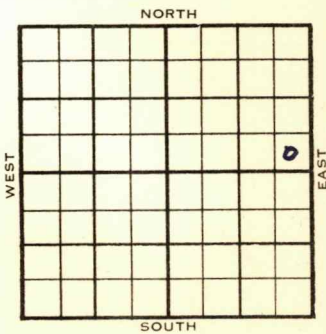

SE SE NE
H&P DHM

1954	ELEVATION 1268'	REPORT
------	--------------------	--------

9/29 Location

10/13 Spud 9-27-54 8-5/8" @ 67
Layton 2133 Miss 2896
TD 2955 D & A

ABANDONED

