

Ellsworth


FORM 51 5M 6-46 PETROL

KANSAS

Section 20 Township 16 Range 10W

Well No. 4 Lanzl

Company H. V. Elwell

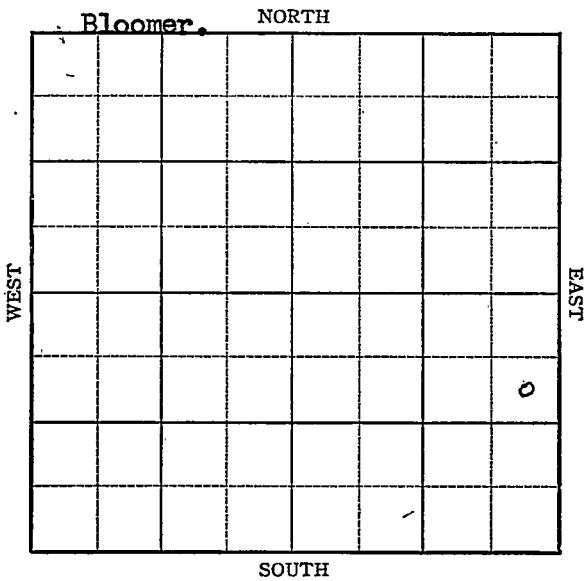

KANSAS

Ellsworth county

Sec. 20 Twp. 16 R. 10W

Well No. 4 Lanzl Farm

H. V. Elwell Company


Bloomer Pool

990 Ft. from N. Line

 Ft. from S. Line

330 Ft. from E. Line

 Ft. from W. Line

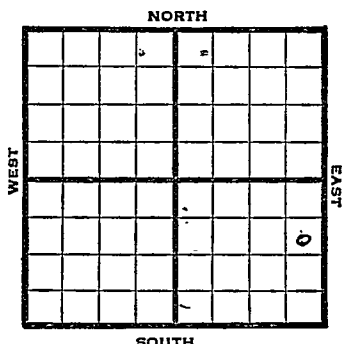

SE NE SE

194' **Elev. 1853' REPORT**

5/7	Location
5/13	Surface Hole.
5/20	10" @ 345 Drlg 2799'
5/27	" "
6/3	Dansing 3008 Arbuckle 3324-26 TD 7" @ 3325 RUST
6/10	TD 3335-500 acid Swb 2 bbl oil
6/17	" " " "
6/24	" " " "
7/1	TD 3335'
7/8	" "
7-16	TD 3335
7/22	"

OVER

1947

7/30

Arb. 3324'

7" @ 3325'

500 Acid

Pump 20 Pot

Gr. 42.7

TD 3335'

COMPLETED

Map No. K55 Sec. 20 Twp. 16 R. 10W

Well No. 4 Lanzl

H. V. Elwell Company

FIRST REPORT Contractor

SE NE SE

SECTION PLAT

990 Ft. from N. Line

 Ft. from S. Line

330 Ft. from E. Line

 Ft. from W. Line

			0

Ellsworth County

Location X

Rig up

Drilling and Remarks:

RECORD

Cased in, ft.

Sand

Gas

Oil

Total Depth

PRODUCTION

1st 24 hrs. Nat.

1st 24 hrs. after shot

Gas Cu. Ft.

Dry Hole

Abandoned

Date


MAY 7 1947 19

S. I. LEWIS Scout

KansasMap No. 55 Sec. 20 Twp. 16 R. 10WWell No. 4 LanzlH. V. Elwell Company**COMPLETE**

Contractor

SE NE SE

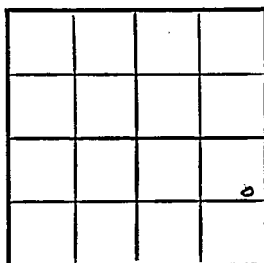E. 1803
SECTION PLAT990 Ft. from N. Line Ft. from S. Line330 Ft. from E. Line Ft. from W. LineEllsworth County**RECORD**Location Rig up

Drilling and Remarks:

*Art 8824**7" 08325**500 acid**Pump 20 ft**42 2/3 in*Cased in., ft.Sand Gas Oil Total Depth 3335**PRODUCTION**1st 24 hrs. Nat. 1st 24 hrs. after shot Gas Cu. Ft.Dry Hole Abandoned

Date

JUL 30 194719S. J. LEWIS

Scout