


Cowley KANSAS

DX 78-1

Section 13 Township 32 Range 6E

Well No. 1 Brown

Company Kirkpatrick

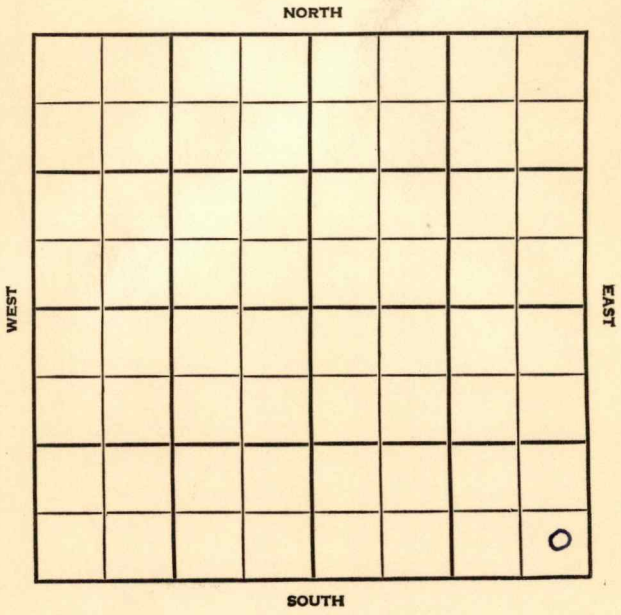

Cowley KANSAS


SEC.	TWP.	R.
13	32	6E ✓

WELL NO. 1 Brown FARM

COMPANY Kirkpatrick

CONTRACTOR Martin & Cash
Wildcat

_____ Ft. from N. Line
 330 _____ Ft. from S. Line
 330 _____ Ft. from E. Line
 _____ Ft. from W. Line

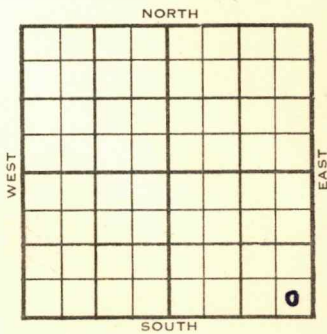

SE SE SE

1954	ELEVATION	REPORT

6/23
6/30

MIR
~~8 1/2"~~ D & A TD 2255
 8" @ 110 Stal. 1789 Lans. 1960
 Hog sd. 2072 Layton 2225
 TD 2255' D & A

ABANDONED

