

ANSAS


Ellsworth

FORM 51 5M PETROL

Section 20 Township -16 Range 10-W

Well No. #1 Emma B. Lanzi

Company Gulf

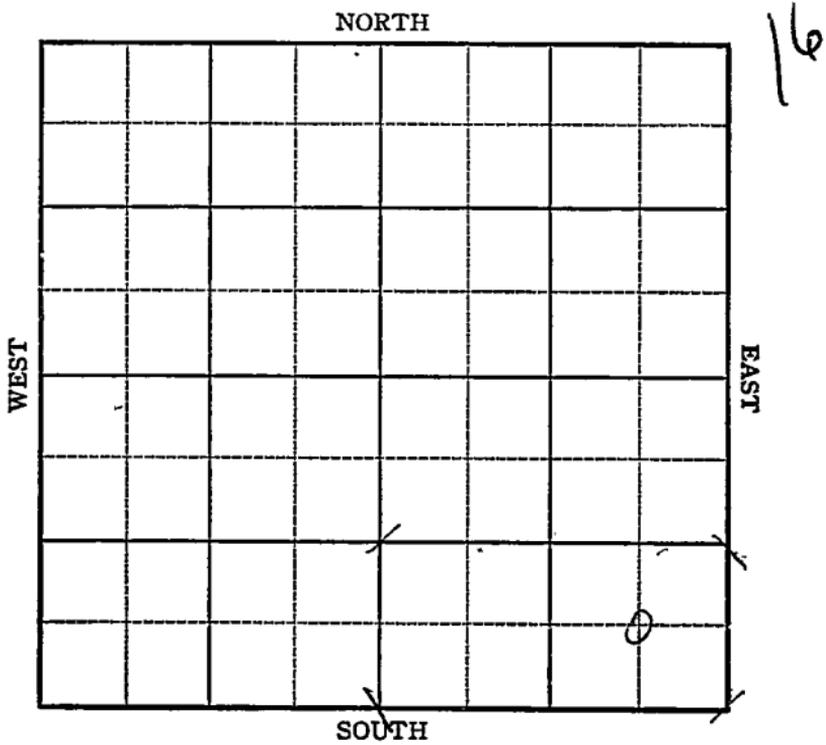

Sec. 20 Twp. 16 R. 10-W

Well No. #1 Emma B. Lanzl Farm


Gulf Company

_____ Ft. from N. Line

660 Ft. from S. Line

660 Ft. from E. Line

_____ Ft. from W. Line,

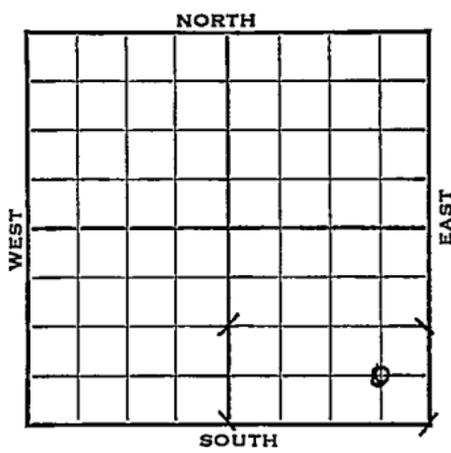

1943 *Elev. 1844* REPORT

8/18 Derrick

8/25 8" @ 368'
WOC.

9/1 Drlg. 2065'8

9/8 Drlg. 2900

9/15 Arb 3310
5" @ 3311
T.D. 3332
Trace oil

9/22 T.D. 337-1000 acid
Swb 10 water in 5 hrs.

9/29 Arb 3310
5" @ 3311
1000 acid
Water
T.D. 3337'

ABANDONED

KANSAS

Map No. 55 Sec. 20 Twp. 16 R. 10WWell No. 1 Emma B. Lanzl

Gulf

Company

FIRST REPORT

Contractor

C SE SE

SECTION PLAT

 Ft. from N. Line660 Ft. from S. Line660 Ft. from E. Line Ft. from W. Line

Stoltenberg Pool

			o

Location Rig up

Drilling and Remarks:

Derrick

RECORD

Cased in., ft.Sand Gas Oil Total Depth

PRODUCTION

1st 24 hrs. Nat. 1st 24 hrs. after shot Gas Cu. Ft.Dry Hole Abandoned

Date

AUG 1 8 1943

19

S. J. LEWIS Scout

KANSAS

Map No. 57 Sec. 20 Twp. 16 R. 10W

Well No. 1 Emma B. Lanzl

Gulf Company

ABANDONED Contractor

C SE SE

SECTION PLAT

_____ Ft. from N. Line

660 Ft. from S. Line

660 Ft. from E. Line

_____ Ft. from W. Line

Stolenberg Pool

Location _____

Rig up _____

Drilling and Remarks:

Pay 3310
5" @ 3311
1000 acid
Water.

RECORD

Cased _____ in., _____ ft.

Sand _____

Gas _____

Oil _____

Total Depth 3332

PRODUCTION

1st 24 hrs. Nat. _____

1st 24 hrs. after shot _____

Gas _____ Cu. Ft.

Dry Hole _____

Abandoned _____

Date _____

SEP. 29 1943 19

S. J. LEWIS Scout