


KANSAS Ellsworth

FORM 51 5M PETROL

Section 20 Township 16 Range 10W

Well No. 4 Valenta

Company Lion Oil

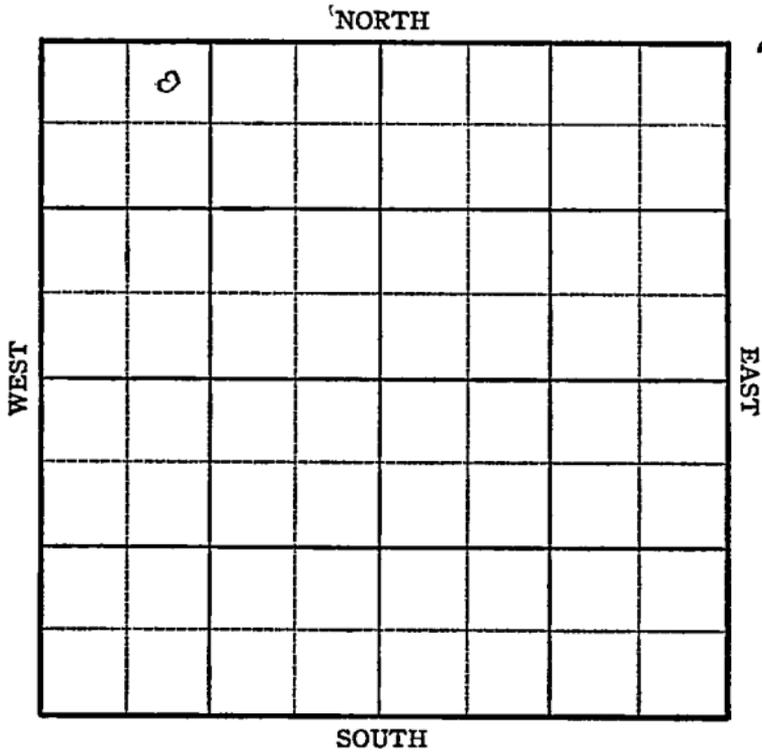

Sec. 20 Twp. 16 R. 10-W

Well No. #4 Valenta Farm


Lion Oil Company

330 Ft. from N. Line

_____ Ft. from S. Line

_____ Ft. from E. Line

990 Ft. from W. Line

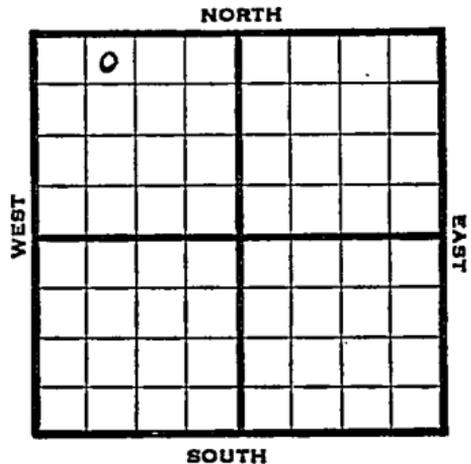

NE NW NW

1945 Elev. 1884 REPORT

- 11/21 RUR
- 11/28 8" @ 356
Drilg. 1888'
- 12/5 Lāns 3040
Arb. 3356
TD 3358' Run csg.
- 12/12 5" @ 3356
TD 3386 wtr.
- 12/19 Arb. 3356
5" @ 3356
TD 3386'

ABANDONED

KANSAS

Kansas Pool Name Stoltenberg

Map No. 5545 Sec. 20 Twp. 16 R. 10W

Well No. 4 Valenta

Lion Oil Company

FIRST REPORT

Contractor _____

NE NW NW

SECTION PLAT

330 Ft. from N. Line

_____ Ft. from S. Line

_____ Ft. from E. Line

990 Ft. from W. Line

| | | | |
|---|--|--|--|
| 0 | | | |
| | | | |
| | | | |
| | | | |

Ellsworth County

Location _____

Rig up _____

Drilling and Remarks:

RUR

RECORD

Cased _____ in., _____ ft.

Sand _____

Gas _____

Oil _____

Total Depth _____

PRODUCTION

1st 24 hrs. Nat. _____

1st 24 hrs. after shot _____

Gas _____ Cu. Ft.

Dry Hole _____

Abandoned _____

Date

NOV 21 1945 19

S. J. LEWIS Scout

KANSAS Kansas Pool Name Stoltenberg PoolMap No. 255 Sec. 20 Twp. 16 R. 10WWell No. 4 ValentaLion Oil CompanyABANDONED Contractor

NE NW NW

E 1, 1884
SECTION PLAT330 Ft. from N. Line Ft. from S. Line Ft. from E. Line990 Ft. from W. Line

| | | | |
|----------|--|--|--|
| <u>0</u> | | | |
| | | | |
| | | | |
| | | | |

Ellsworth County

Location _____

Rig up _____

Drilling and Remarks:

Core 33065" 23356

RECORD

Cased _____ in., _____ ft.

Sand _____

Gas _____

Oil _____

Total Depth 3376

PRODUCTION

1st 24 hrs. Nat. _____

1st 24 hrs. after shot _____

Gas _____ Cu. Ft.

Dry Hole _____

Abandoned _____

Date

DEC 19 1945

19

S. J. LEWIS Scout