


Section 20 Township 16 Range 10W

Well No. #1 Valento

Company Ingling & Alpine

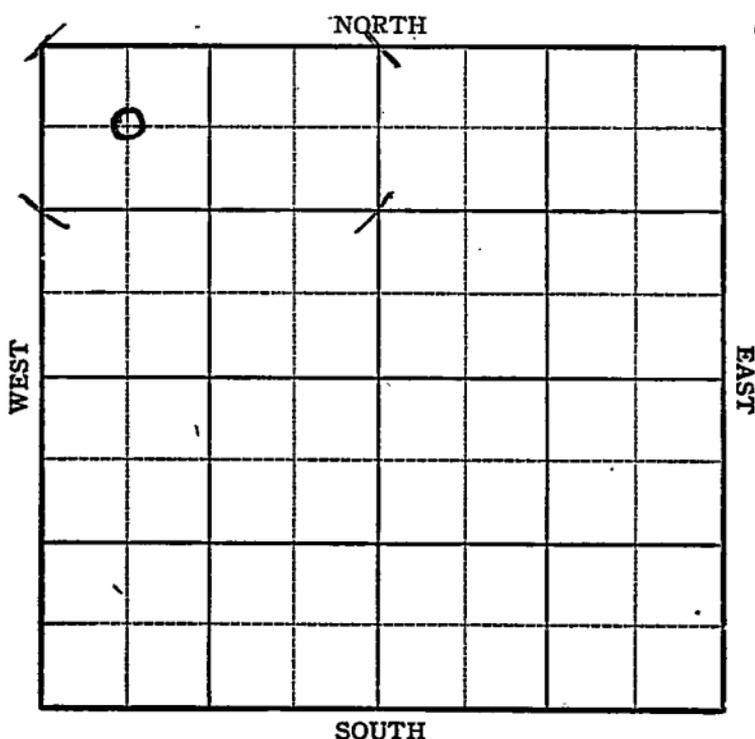

Sec. 20 Twp. 16 R. 10W

Well No. #1 Valento Farm

Ingling & Alpine Company

Stoltenberg


660 Ft. from N. Line

_____ Ft. from S. Line

_____ Ft. from E. Line

660 Ft. from W. Line

Elvd. 1885

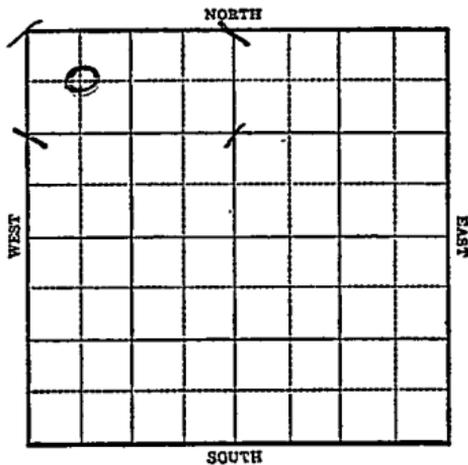

1944

R E P O R T

| | |
|------|---|
| 3/8 | Rotary |
| 3/16 | 8" @340 Drilling 2035 |
| 3/22 | Drig. 2995' |
| 3/29 | Arb 3350-56 TD 4" @ 3353 Rust |
| 4/5 | " |
| 4/12 | " |
| 4/19 | TD 3389-1000 acid Swb 4 oil per hr. |
| 4/26 | " " " |
| 5/3 | " " " |
| 5/10 | " " |
| 5/17 | " " |
| 5/24 | " " |
| 5/31 | " " |
| 6/7 | 4" @ 3353 Arb. 3350 TD 3389 1000 acid Pump 100 Pot. Grav. 42.1 |

COMPLETED

~~KANSAS~~Map No. 52 Sec. 20 Twp. 16 R. 10WWell No. 1 ValentoIngling & Alpine CompanyFIRST REPORT Contractor

C NW NW

SECTION PLAT

660 Ft. from N. Line Ft. from S. Line Ft. from E. Line660 Ft. from W. Line

| | | | |
|---|--|--|--|
| o | | | |
| | | | |
| | | | |
| | | | |

Stoltenberg PoolLocation Rig up

Drilling and Remarks:

Rotary

RECORD

Cased in., ft.Sand Gas Oil Total Depth

PRODUCTION

1st 24 hrs. Nat. 1st 24 hrs. after shot Gas Cu. Ft.Dry Hole Abandoned

Date

MAR 8 1944 19S. J. LEWIS Scout

KANSAS

Pool Name Stoltenberg

Map No. 55 Sec. 20 Twp. 16 R. 10W

Well No. 1 Valento

Ingling & Alpine Company

COMPLETED Contractor

C NW NW

SECTION PLAT

660 Ft. from N. Line

_____ Ft. from S. Line

_____ Ft. from E. Line

660 Ft. from W. Line

| | | | |
|---|--|--|--|
| o | | | |
| | | | |
| | | | |
| | | | |
| | | | |

Ellsworth County

RECORD

Location _____

Cased _____ in., _____ ft.

Rig up _____

Sand _____

Drilling and Remarks:

Gas _____

Car 43350

Oil _____

Total Depth 3389

4" C 3353

PRODUCTION

1000 acid

1st 24 hrs. Nat. _____

Pump 100 Pst

1st 24 hrs. after shot _____

Gas _____ Cu. Ft.

Dry Hole _____

42 1/2 Gr

Abandoned _____

Date

JUN 7 1944 19

S. J. LEWIS Scout