


Section 21 Township 16 Range 10-W

Well No. #2 Boldt

Company Mercury Drlg.

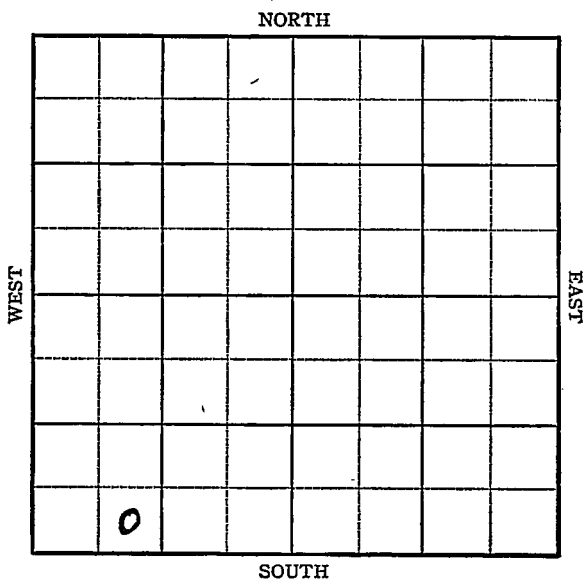

KANSAS

Ellsworth County

Sec. 21 Twp. 16 R. 10W

Well No. #2 Boldt Farm

Mercury Drlg. Company


Bloomer

Ft. from N. Line

330 Ft. from S. Line

Ft. from E. Line

990 Ft. from W. Line

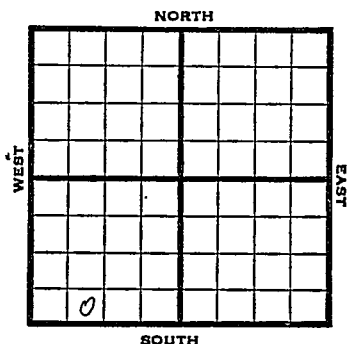

SE SW SW

1946 1 lev. 1853 REPORT

2/27 8" @ 250' WOC
3/7 Drlg. 2782'
3/14 Lans. 3005' Cong. 3315'
Arb. 3324' T.D. 3332'
5" - 3326' RUST.
3/21 T.D. 3344' 1600 acid.
3/28 " " "
4/4 Swb. 1 oil per hr. 8 hrs.
4/10 Pump 21 oil in 12 hrs.
4/17 Arb. 3324
5" @ 3326
1600 acid.
TD 3344
Pump 38 Pot.
Grav. 42.0

COMPLETED

KANSAS Kansas Pool Name BloomerMap No. 35 Sec. 21 Twp. 16 R. 10WWell No. 2 BoldtMercury Drlg.

Company

FIRST REPORT

Contractor

SE SW SW

SECTION PLAT

Ft. from N. Line

330 Ft. from S. Line

Ft. from E. Line

990 Ft. from W. LineEllsworth County

Location

Rig up

Drilling and Remarks:

8"-250 WOC

RECORD

Cased _____ in., _____ ft.

Sand _____

Gas _____

Oil _____

Total Depth _____

PRODUCTION

1st 24 hrs. Nat. _____

1st 24 hrs. after shot _____

Gas _____ Cu. Ft.

Dry Hole _____

Abandoned _____

Date

FEB 27 1946

19

S. J. LEWIS

Scout

KANSAS Pool Name Bloomer
 Map No. 3.3 Sec. 21 Twp. 16 R. 10W
 Well No. 2 Boldt

Mercury Drlg.

Company

COMPLETED

Contractor

SE SW SW

E 11833
 SECTION FLAT

0			

Ft. from N. Line

330 Ft. from S. Line

Ft. from E. Line

990 Ft. from W. Line

Ellsworth County

Location

Rig up

Drilling and Remarks:

Per 4324
5" 3326
1600000'
Pump 3800

42° Gr

RECORD

Cased _____ in., _____ ft.

Sand _____

Gas _____

Oil _____

Total Depth 12344

PRODUCTION

1st 24 hrs. Nat. _____

1st 24 hrs. after shot _____

Gas _____ Cu. Ft.

Dry Hole _____

Abandoned _____

Date

APR 17 1946 19

S. J. LEWIS

Scout