

KANSAS

Calloworth


Form 51-5M-11-31-Palace

Map No. _____ Sec. 21 Twp. 16 R. 10^W

Well No. 6 Frevert (Frevert) Farm

Gypsy + Stanolind Company

NORTH

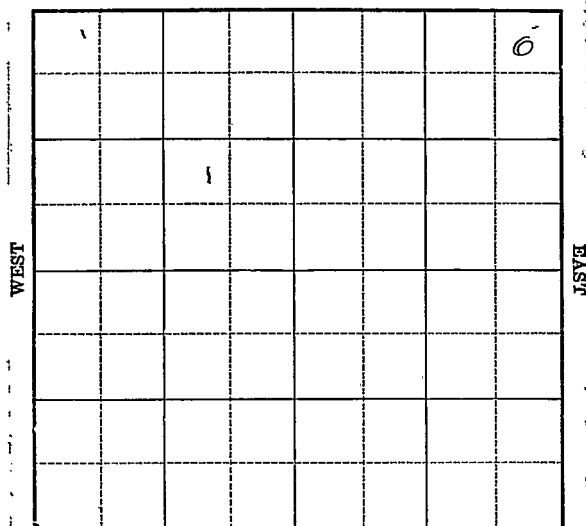

SOUTH

O. W. D. D

Location _____

Drilling Remarks _____

Rig Up _____

Drilling Remarks _____

RECORD

Cased _____ in. _____ ft.

Sand _____

Gas _____

Oil _____

Total Depth _____

PRODUCTION

1st 24 hrs. Nat. _____

1st 24 hrs. after shot _____

Gas _____ cu. ft.

Dry Hole _____

Abandoned _____

Ellsworth

Form 252-A
5M 4-32 MPC

KANSAS

Map No. _____ Sec. 21 Twp. 16 R. 10^W

Well No. 1-Friervert Farm _____


Gypsy-Stanolind Company

330 Ft. from N. Line

_____ Ft. from S. Line

330 Ft. from E. Line

_____ Ft. from W. Line

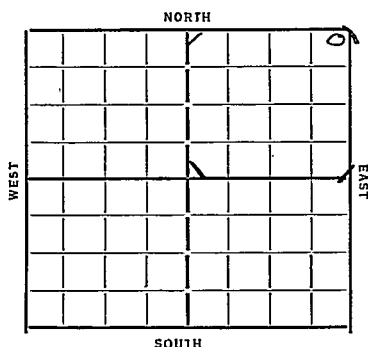

Date
1933

REPORT

O. W. D. D

3/15 R.O.G.
3/27 Rigging up
3/29 20" 286 Wdly 390'
4/4 15" 487-13"-1080 Dely 1455'
4/12 10" 1995 dely 2110'
4/19 dely 2835'
4/26 8"-3142 ~~rig~~ running 6" 3339'
5/4 6" 3342' Silencer 3345-60'
2800' oil in 20 hrs No test
5/10 swab 287 bbls 24-hrs
5/17 _____
5/24 Pump 115-bbls 10-hrs acidize
5/31 Silencer line 3345-60
Treated 1000 gallons
acid swab 60 bbls
per hour

COMPLETED

OVER

O. W. D. D

1936

11/4-Old T. D. 3360

Rigging up for Water disposal well

11/12--Drlg. 3421.

11/19--Drlg. 3700'.

11/27 Drlg. 3850'.

12/3 6" @ 3344'. T. D. 3863'.

Under ream 6".

12/10 6" @ 3460'. Drlg. 3863'.

12/17 T. D. 3954'. Shut down.

12/22 Sand 3408'. T. D. 3954'.

Water disposal.

Will take 250 bbls. water per
hour.

ABANDONED

55 KANSAS

Map No. _____ Sec. 21 Twp. 16 R. 10 W

Well No. 1 Frevert

Gypsy & Stanoline Company

Contractor

FIRST REPORTS

330 Ft. from N. Line

Ft. from S. Line

330 Ft. from E. Line

Ft. from W. Line

SECTION PLAT

Location _____

Rig up _____

Drilling and Remarks:

R. S.

RECORD

Cased _____ in., _____ ft.

Sand _____

Gas _____

Oil _____

Total Depth _____

PRODUCTION

1st 24 hrs. Nat. _____

1st 24 hrs. after shot _____

Gas _____ Cu. Ft.

Dry Hole _____

Abandoned _____

Date

MAR 1 5 1933

CHAS. L. SHERWOOD

192

Scout

Ellsworth **KANSAS**
 Map No. _____ Sec. *21* Twp. *16* R. *10W*
 Well No. *55* - *1* - *Prevert*

Sydney - Stanolind Company
 _____ Contractor

SECTION PLAT

330 Ft. from N. Line

_____ Ft. from S. Line

330 Ft. from E. Line

_____ Ft. from W. Line

			O

COMPLETED

Location _____

Rig up _____

Drilling and Remarks:

Siliceous line

3345-60

Treated 1000

gallons acid.

Swab 60 Bls

Per hr

RECORD

Cased _____ in., _____ ft.

Sand _____

Gas _____

Oil _____

Total Depth *3360*

PRODUCTION

1st 24 hrs. Nat. _____

1st 24 hrs. after shot _____

Gas _____ Cu. Ft.

Dry Hole _____

Abandoned _____

Date

5/31/33 192

O. Mannschreck Scout

Map No. 55 Sec. 21 Twp. 16 R. 10W

Well No. 1 Faver

Standard & Gulf Company

Contractor

SECTION PLAT

			0

230 Ft. from N. Line

_____ Ft. from S. Line

320 Ft. from E. Line

_____ Ft. from W. Line

FIRST REPORT

OW II

Location _____

Rig up _____

Drilling and Remarks:

Old TD 3360
Rigging up for
water disposal
well

RECORD

Cased _____ in., _____ ft.

Sand _____

Gas _____

Oil _____

Total Depth _____

PRODUCTION

1st 24 hrs. Nat. _____

1st 24 hrs. after shot _____

Gas _____ Cu. Ft.

Dry Hole _____

Abandoned _____

Date

Nov 2 1938

C. J. EWING Scout

KANSAS

Map No. 55 Sec. 21 Twp. 16 R. 10WWell No. 1 F. 2228Standard & Gulf Company

Contractor

SECTION PLAT

330 Ft. from N. Line Ft. from S. Line330 Ft. from E. Line Ft. from W. Line

			0

ABANDONED**ABANDONED**Location Rig up

Drilling and Remarks:


RECORD

Cased in., ft.Sand Gas Oil Total Depth 3954

PRODUCTION

1st 24 hrs. Nat. 1st 24 hrs. after shot Gas Cu. Ft.Dry Hole Abandoned

Date

DEC 22 1936₁₉

S. J. LEWIS

Scout