


Ellsworth

Form 51-5M-5-34-Palace

Map No. **KANSAS** Sec. 21 Twp. 16 R. 10^W

Well No. 2 Report Farm
Standard & Gypsy Company

NORTH

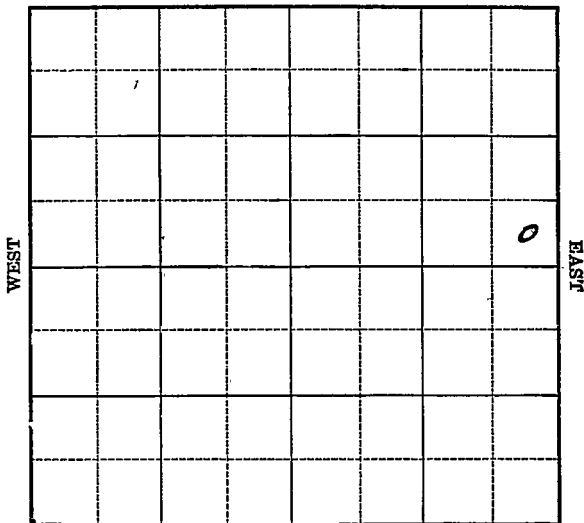

SOUTH

Location _____

Drilling Remarks _____

Rig Up _____

Drilling Remarks _____

RECORD

Cased _____ in. _____ ft.

Sand _____

Gas _____

Oil _____

Total Depth _____

PRODUCTION

1st 24 hrs. Nat. _____

1st 24 hrs. after shot _____

Gas _____ cu. ft.

Dry Hole _____

Abandoned _____

Ellsworth

Map No. KANSAS Sec. 21 Twp. 16 R. 10 W

Well No. 2 7 revert Farm


Stanford & Gypsy Company

 Ft. from N. Line

330 Ft. from S. Line

330 Ft. from E. Line

 Ft. from W. Line

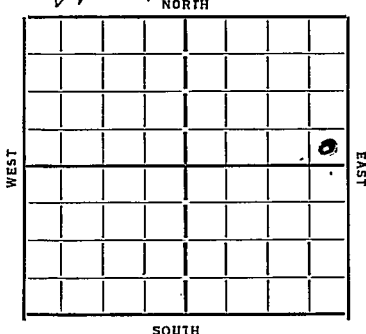

Date 7/25/34

REPORT

7/25 Location
8/7 — 8/7 —
8/16 Blg.
8/22 — 8/30 — 9/6 — 9/13 —
9/20 — 9/27 — 10/4 — 10/11 —
10/18 — 10/25 — 11/2 — 11/8 —
11/15 —
11/22 Blg 1515
11/28 " 2530
12/6 " 3200 Lansing 3004
12/13 Simpson 3309 Sil 3317
Cm 7" T1 3329 Rust
12/21 Rust 566 Blk 6 hrs
12/26 Siliceous 3317 T1 3322
2285 Blk Natural

COMPLETED

KANSAS

Map No. 55 Sec. 21 Twp. 16 R. 10WWell No. 2-1/4 revertStanolind & Pyper Company
Contractor

FIRST REPORTS

SECTION PLAT

			0

_____ Ft. from N. Line

330 Ft. from S. Line330 Ft. from E. Line

_____ Ft. from W. Line

Location ✓

Rig up _____

Drilling and Remarks:

RECORD

Cased _____ in., _____ ft.

Sand _____

Gas _____

Oil _____

Total Depth _____

PRODUCTION

1st 24 hrs. Nat. _____

1st 24 hrs. after shot _____

Gas _____ Cu. Ft.

Dry Hole _____

Abandoned _____

Date

7-25-34 19ORVAL MANNSCHRECK
Scout

Map No. 55 Sec. 21 Twp. 16 R. 10WWell No. 2- To reportStanolind & Gypsy Company

Contractor

COMPLETED

SECTION PLAT

			0

Ft. from N. Line

330 Ft. from S. Line330 Ft. from E. Line

Ft. from W. Line

Location

Rig up

Drilling and Remarks:

RECORD

Cased _____ in., _____ ft.

Sand silicous 3317

Gas _____

Oil _____

Total Depth 3322

PRODUCTION

1st 24 hrs. Nat. _____

1st 24 hrs. after shot _____

Gas _____ Cu. Ft.

Dry Hole _____

Abandoned _____

Date

ORVAL MANNSCHRECK

12-26-34 192

Scout

2285 lbs
Natural