

Ellsworth

Form 51-5M-5-34-Palace

Map No. _____ Sec. 21 Twp. 16 R. 10 W

Well No. #3 Freight Farm _____

Stanshik & Gypsey Company _____

NORTH

WEST

EAST

SOUTH

Location _____

Drilling Remarks _____

Rig Up _____

Drilling Remarks _____

RECORD

Cased _____ in. _____ ft.

Sand _____

Gas _____

Oil _____

Total Depth _____

PRODUCTION

1st 24 hrs. Nat. _____

1st 24 hrs. after shot _____

Gas _____ cu. ft.

Dry Hole _____

Abandoned _____

Ellsworth

Map No. KANSAS Sec. 21 Twp. 16 R. 10^W

Well No. 3 Fract Farm


Stanolink & Gypsy Company

1321 Ft. from N. Line

_____ Ft. from S. Line

330 Ft. from E. Line

_____ Ft. from W. Line

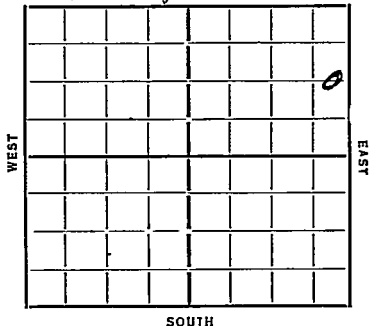

Date 1/25

REPORT

1/23 Blky Rot.
1/31 Rgn
2/7 Alg 400
2/14 " 2400
2/21 " 2815
2/28 " 3290
3/7 Simpson 3317 Siliceous 3330
7" 3330 Rust
3/14 T 7 3337 2000 / hr
Sept 80 Bls / hr Tubing
3/20 Siliceous 3330 T 7 3337
797 Bls oil 10% Water

COMPLETED

KANSAS

Map No. 55 Sec. 21 Twp. 16 R. 10W

Well No. 3-Exhibit

Stanford & Mays Company

Contractor

FIRST REPORTS


SECTION PLAT

1321 Ft. from N. Line

..... Ft. from S. Line

330 Ft. from E. Line

..... Ft. from W. Line

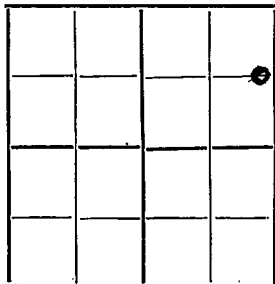

Location.....

Rig up.....

Drilling and Remarks:

Bed Rot

RECORD

Cased.....in.,ft.

Sand.....

Gas.....

Oil.....

Total Depth.....

PRODUCTION

1st 24 hrs. Nat.....

1st 24 hrs. after shot.....

Gas.....Cu. Ft.

Dry Hole.....

Abandoned.....

Date

1-31-35 192.....

ORVAL MANNSCHRECK

.....Scout

Map No. 55 Sec. 21 Twp. 16 R. 10W

Well No. 3-Open

Stanford & Gypsy Company

Contractor

COMPLETED

SECTION PLAT

132 Ft. from N. Line

..... Ft. from S. Line

330 Ft. from E. Line

..... Ft. from W. Line

			0

Location.....

Rig up.....

Drilling and Remarks:

797 lbs oil
100% water

RECORD

Cased..... in., ft.
~~Sand~~ blue 3330
Gas.....
Oil.....
Total Depth 3337

PRODUCTION

1st 24 hrs. Nat.....
1st 24 hrs. after shot.....
Gas..... Cu. Ft.
Dry Hole.....
Abandoned.....

Date

3-20-35 192.....

ORVAL MANNSCHECK

Scout