


Ellsworth

Form 51-5M-5-34-Palace

Map No. KANSAS Sec. 21 Twp. 16 R. 10 W

Well No. 4- Greent Farm
Stanovich & Gypsey Company

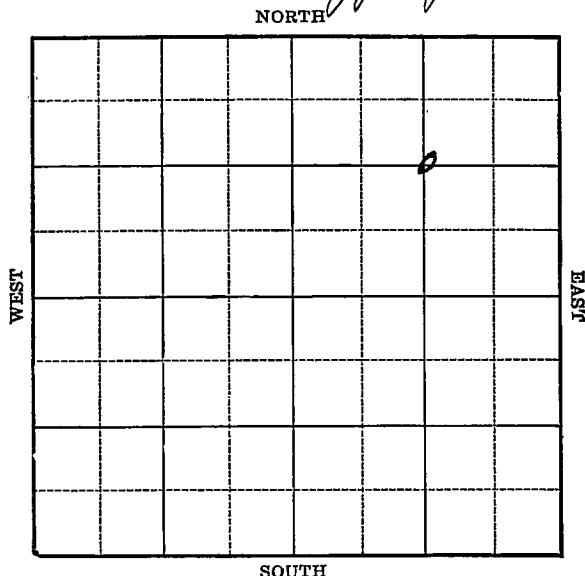

Location _____

Drilling Remarks _____

RECORD

Cased _____ in. _____ ft.

Sand _____

Gas _____

Oil _____

Total Depth _____

Rig Up _____

Drilling Remarks _____

PRODUCTION

1st 24 hrs. Nat. _____

1st 24 hrs. after shot _____

Gas _____ cu. ft.

Dry Hole _____

Abandoned _____

Ellsworth

Map No. KANSAS Sec. 21 Twp. 16 R. 10 W

Well No. 4 - Frevert Farm


Standard & Supply Company

1320 Ft. from N. Line

_____ Ft. from S. Line

_____ Ft. from E. Line

1320 Ft. from W. Line

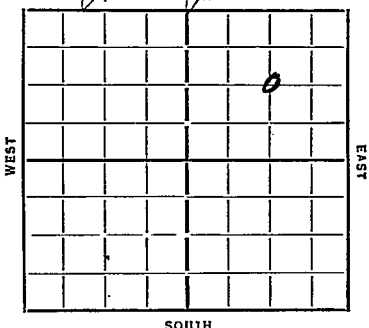

Date

REPORT

1935
3/27 Location
4/4 — 411 —
4/18 Bldg
4/26 13" 213 WOC
5/2 Bldg 1815
5/9 " 2965
5/16 Sil & 7" 3349-51 T7 Rust
5/23 Bailing
5/29 Sil 3349 Pay 3350
T7 3355 1600' oil 6 hrs.
6/5 Siliceous 3349 T7 3355
382 Bbls.

COMPLETED

Map No. 55 Sec. 21 Twp. 16 R. 10W

Well No. 4-Prevert

Stanoline & Gypsy Company

Contractor

FIRST REPORT


SECTION PLAT

1320 Ft. from N. Line

_____ Ft. from S. Line

_____ Ft. from E. Line

1320 Ft. from W. Line

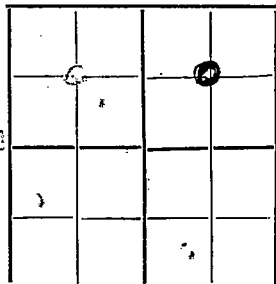

Location ✓

Rig up _____

Drilling and Remarks:

RECORD

Cased _____ in., _____ ft.

Sand _____

Gas _____

Oil _____

Total Depth _____

PRODUCTION

1st 24 hrs. Nat. _____

1st 24 hrs. after shot _____

Gas _____ Cu. Ft.

Dry Hole _____

Abandoned _____

Date

3-27-30 192 ORVAL MANNSCHRECK Scout

Edwards

KANSAS

Map No. *55* Sec. *21* Twp. *16* R. *10W*

Well No. *4 - Fr. revert*

Stanolind & Gypsy Company

Contractor

COMPLETED

SECTION PLAT

1320 Ft. from N. Line

..... Ft. from S. Line

..... Ft. from E. Line

1320 Ft. from W. Line

Location.....

Rig up.....

Drilling and Remarks:

382 bbls

RECORD

Cased..... in., ft.

Sand *siliceous* *3349*

Gas.....

Oil.....

Total Depth *3355*

PRODUCTION

1st 24 hrs. Nat.....

1st 24 hrs. after shot.....

Gas..... Cu. Ft.

Dry Hole.....

Abandoned.....

Date

6-5-35 192..... Scout