


Ellsworth

KANSAS

Section 21 Township 16 Range 10-W

Well No. #1 Stoltenberg

Company Western Kansas O & R

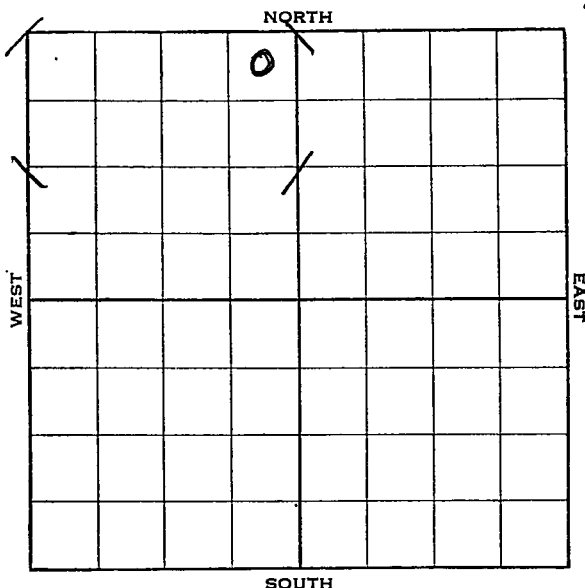

Ellsworth KANSAS

Map No. 55 Sec. 21 Twp. 16 R. 10WWell No. 1 StoltenbergWestern Kans. O & R Company


Contractor

FIRST REPORT

NE NW

330 Ft. from N. Line Ft. from S. Line330 Ft. from E. Line Ft. from W. Line

SECTION PLAT

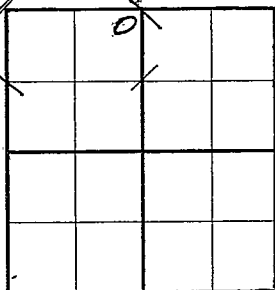Location Rig up

Drilling and Remarks:

S.H.

RECORD

Cased in., ft.Sand Gas Oil Total Depth

PRODUCTION

1st 24 hrs. Nat. 1st 24 hrs. after shot Gas Cu. Ft.Dry Hole Abandoned

Date

APR 6 - 1938

19

H. D. Hatfield Scout

Ellsworth KANSAS

Map No. 53 Sec. 21 Twp. 16 R. 10WWell No. 1 StoltenbergWestern Kans. O & R Company

Contractor

ABANDONED

NE NW

SECTION PLAT

330 Ft. from N. Line Ft. from S. Line330 Ft. from E. Line Ft. from W. Line

	0		

Location Rig up

Drilling and Remarks:

HFW

DVA

RECORD

Cased 7 in., 3395 ft.Sand Arb 3392?Gas Oil Total Depth 3441

PRODUCTION

1st 24 hrs. Nat. 1st 24 hrs. after shot Gas Cu. Ft.Dry Hole Abandoned

Date

MAY 4 - 1938

19

H. D. Hatfield Scout