

KANSAS


Ellsworth

FORM 51' 10M 12-46 PETROL

Section 21 Township 16 Range 10-W

Well No. #1 M. Stoltenberg

Company Derby Oil

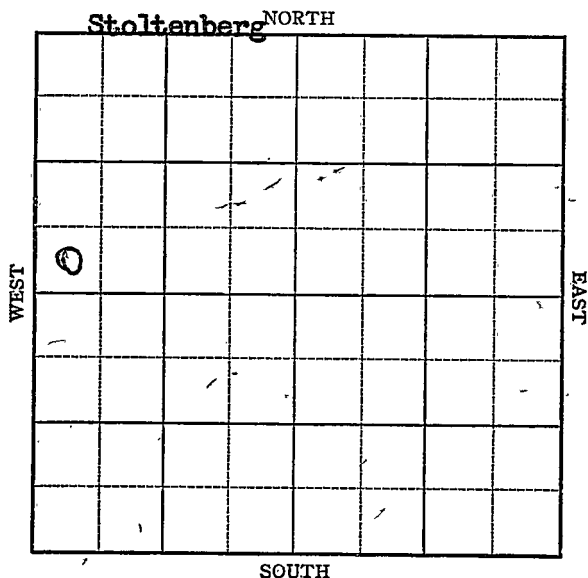

KANSAS

Ellsworth Co

Sec. 21 Twp. 16 R. 10-W

Well No. 1 M. Stoltenberg Farm

Derby Oil

Company

Stoltenberg

Ft. from N. Line

330


Ft. from S. Line

Ft. from E. Line

330

Ft. from W. Line

SW NW

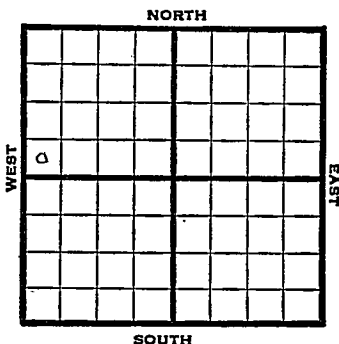

1947

Elev. 1860' REPORT

8/20

Loc.

8/27

"

9/3

8" @ 430  
Drlg 2000

9/10

Lans. 3016'  
Arb. 3340'  
TD 3348'

ABANDONED

Map No. \_\_\_\_\_ Sec. 21 Twp. 16 R. 10W

Well No. 1 M. Stoltenberg

Derby Oil Company

## FIRST REPORT

Contractor

SW NW


## SECTION PLAT

\_\_\_\_\_ Ft. from N. Line

330 \_\_\_\_\_ Ft. from S. Line

\_\_\_\_\_ Ft. from E. Line

330 \_\_\_\_\_ Ft. from W. Line

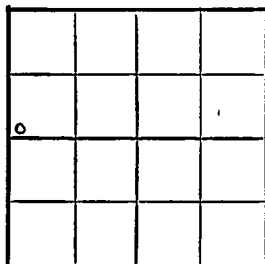

Ellsworth County

Location K

Rig up

Drilling and Remarks:

## RECORD

Cased \_\_\_\_\_ in., \_\_\_\_\_ ft.

Sand \_\_\_\_\_

Gas \_\_\_\_\_

Oil \_\_\_\_\_

Total Depth \_\_\_\_\_

## PRODUCTION

1st 24 hrs. Nat. \_\_\_\_\_

1st 24 hrs. after shot \_\_\_\_\_

Gas \_\_\_\_\_ Cu. Ft.

Dry Hole \_\_\_\_\_

Abandoned \_\_\_\_\_

Date

AUG 20 1947

19

S. J. LEWIS

Scout

Map No. 55 Sec. 21 Twp. 16 R. 10W

Well No. 1 M. Stoltenberg

Derby Oil Company  
**ABANDONED**

SW NW Contractor


*E. 1860*  
**SECTION PLAT**

         Ft. from N. Line

330 Ft. from S. Line

         Ft. from E. Line

330 Ft. from W. Line

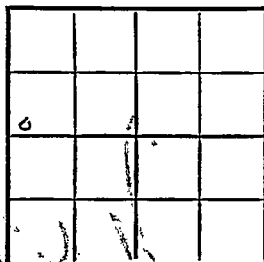

Ellsworth County

Location         

Rig up         

Drilling and Remarks:

*Lewis 8016*

*Ar 80140*

**RECORD**

Cased          in,          ft.

Sand         

Gas         

Oil         

Total Depth 2845

**PRODUCTION**

1st 24 hrs. Nat.         

1st 24 hrs. after shot         

Gas          Cu. Ft.

Dry Hole         

Abandoned         

Date

SEP 10 1947

19

S. J. LEWIS

Scout