


Ellsworth

KANSAS

Form 51-5M-11-31-Palace

Map No. _____ Sec. 22 Twp. 16 R. 10W

Well No. #1 Stattenberg Farm
Gypsy + Stanolind Company

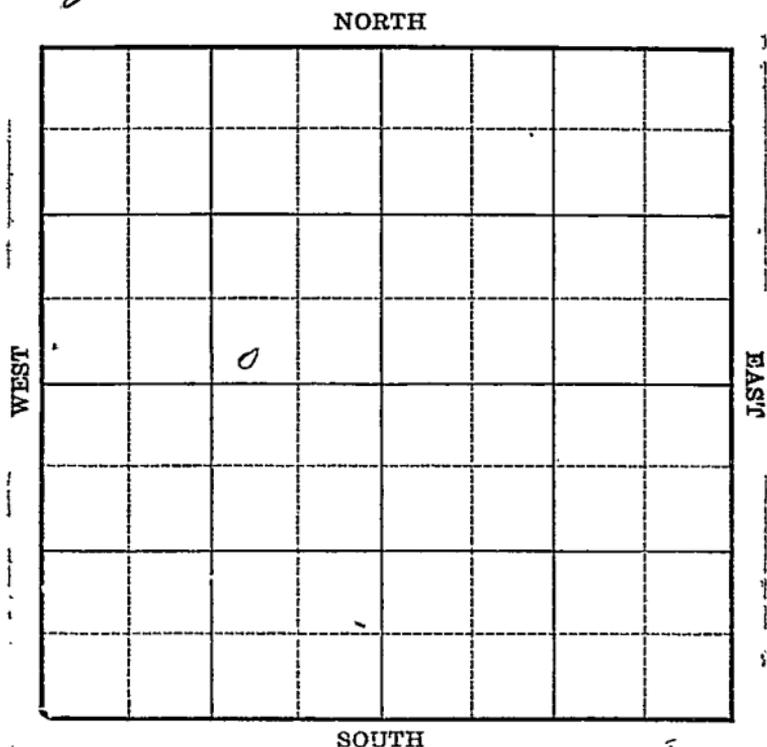

Location _____

Drilling Remarks _____

Rig Up _____

Drilling Remarks _____

RECORD

Cased _____ in. _____ ft.

Sand _____

Gas _____

Oil _____

Total Depth _____

PRODUCTION

1st 24 hrs. Nat. _____

1st 24 hrs. after shot _____

Gas _____ cu. ft.

Dry Hole _____

Abandoned _____

Ellsworth

KANSAS

Form 252-A
5M 4-32 MPC

Map No. _____ Sec. 22 Twp. 16 R. 10W

Well No. #1 Staltemberg Farm


Gypsy + Stanolind Company

_____ Ft. from N. Line

330 Ft. from S. Line

990 Ft. from E. Line

_____ Ft. from W. Line

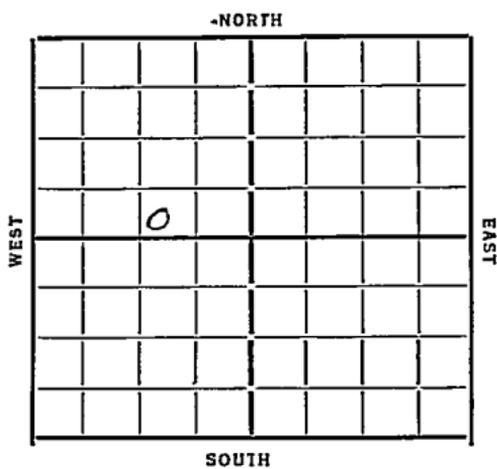

Date
1933

REPORT

7/19 Bldg rig

7/26 20" - 225' dily 450'

8/2 12" - 960' dily 1335'

8/9 10" 1955' " 2020'

8/16 dily 2875'

8/23 Cong 3315' dily 3335'

8/30 Top Siliceous 3337 T.D. 3345 800' oil
1700 water

9/6 Sand Siliceous 3337
T.D. 3345 211 bbls oil
170 bbls water

COMPLETED

Map No. Sec. *22* Twp. *16* R. *10W*

Well No. # *1 - Stoltenberg*

Gypsy + Standlind Company

..... Contractor

SECTION PLAT

..... Ft. from N. Line

330 Ft. from S. Line

990 Ft. from E. Line

..... Ft. from W. Line

FIRST REPORTS

Location.....

Rig up.....

Drilling and Remarks:

B. Rig

RECORD

Cased..... in., ft.

Sand.....

Gas.....

Oil.....

Total Depth.....

PRODUCTION

1st 24 hrs. Nat.

1st 24 hrs. after shot.....

Gas..... Cu. Ft.

Dry Hole.....

Abandoned.....

Date

7/19/33 192 *Oval Manschreck*

Edgeworth

Map No. 55 Sec. 22 Twp. 16 R. 10W

Well No. 1 - Stoltenberg

Byrney + Sandollind Company
Contractor

SECTION PLAT

	0		

..... Ft. from N. Line

330 Ft. from S. Line

990 Ft. from E. Line

..... Ft. from W. Line

~~COMPLETED~~

Location.....

Rig up.....

Drilling and Remarks:

211 oil
170 water

RECORD

Cased..... in., ft.
 Sand Siliceous 3337
 Gas.....
 Oil.....
 Total Depth 3345

PRODUCTION

1st 24 hrs. Nat.....
 1st 24 hrs. after shot.....
 Gas..... Cu. Ft.
 Dry Hole.....
 Abandoned.....

Date

9/6/33

Scout