

KANSAS

Ellsworth


Form 51-5M-11-31-Palace

Map No. Sec. 22 Twp. 16 R. 10 W

Well No. 3 Stoltenberg Farm

Leppay & Stanolind Company

NORTH

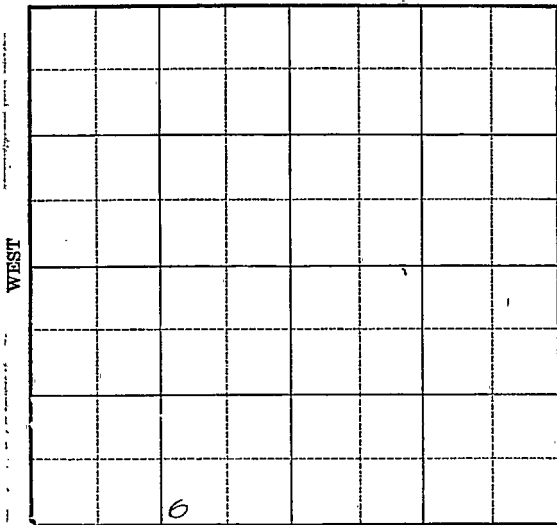

SOUTH

Location

Drilling Remarks

Rig Up

Drilling Remarks

RECORD

Cased in. ft.

Sand

Gas

Oil

Total Depth

PRODUCTION

1st 24 hrs. Nat.

1st 24 hrs. after shot

Gas cu. ft.

Dry Hole

Abandoned

Ellsworth

Form 252-A
5M 4-32 MPC

KANSAS

Map No. _____ Sec. 22 Twp. 16 R. 10^W

Well No. 3 Slattenberg Farm


Gypsy & Stanolind Company

_____ Ft. from N. Line

330 Ft. from S. Line

990 Ft. from E. Line

_____ Ft. from W. Line

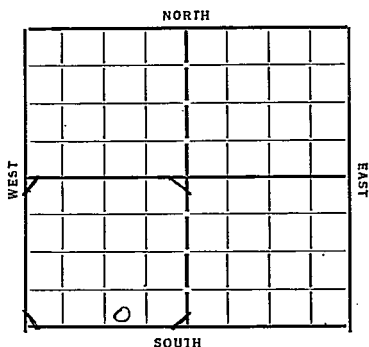

Date
1933

REPORT

<u>3/15</u>	<u>R.O.G.</u>
<u>3/22</u>	<u>Rigging up</u>
<u>3/29</u>	<u>Spud 150'</u>
<u>4/4</u>	<u>20" 199 dily 615'</u>
<u>4/12</u>	<u>12" 945' dily 1500' to 1995 dily 2410'</u>
<u>4/12</u>	<u>12" 945 dily 1500</u>
<u>4/19</u>	<u>dily 2075'</u>
<u>4/26</u>	<u>10" 1965 fag 2650'</u>
<u>5/4</u>	<u>—</u>
<u>5/10</u>	<u>—</u>
<u>5/17</u>	<u>8" 2663 dily 2820'</u>
<u>5/24</u>	<u>Show Oil 3300' Cement 6" W.C.C.</u>
<u>6/1</u>	<u>Dilicent line 3301 T.D. 3317</u>
	<u>Pay 3303-10' - cost 45 Bw</u>
	<u>per hour.</u>
<u>6/8</u>	<u>—</u>
<u>6/15</u>	<u>—</u>
<u>6/21</u>	<u>—</u>
<u>6/28</u>	<u>pumped 414 bbls 12 hrs well</u>
	<u>widely T.D. 3317'</u>
	<u>(over)</u>

7/12- Top Silicious 3301
T. D. 3317
1579 bbls

COMPLETED

Ellsworth

55 KANSAS

Map No. _____ Sec. 22 Twp. 16 R. 10^W

Well No. 3 Skohtenberg

Gypsy & Skohtenberg Company

Contractor

FIRST REPORTS


Ft. from N. Line

330 Ft. from S. Line

990 Ft. from E. Line

Ft. from W. Line

SECTION PLAT

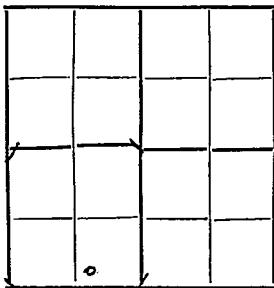

Location _____

Rig up _____

Drilling and Remarks:

P.O. G.

RECORD

Cased _____ in., _____ ft.

Sand _____

Gas _____

Oil _____

Total Depth _____

PRODUCTION

1st 24 hrs. Nat. _____

1st 24 hrs. after shot _____

Gas _____ Cu. Ft.

Dry Hole _____

Abandoned _____

Date

MAR 15 1933

CHAS. L. SHERWOOD

192

Scout

Ellsworth
 Map No. _____ Sec. *22* Twp. *16* R. *10W*
55
 Well No. *3* *Stollenburg*
Gypsy + Stanolind Company
 Contractor

SECTION PLAT

Ft. from N. Line

330 Ft. from S. Line*990* Ft. from E. Line

Ft. from W. Line

COMPLETED

Location _____

Rig up _____

Drilling and Remarks:

*Sil 3301**1579 bbls*

RECORD

Cased _____ in., _____ ft.

Sand _____

Gas _____

Oil _____

Total Depth *3317*

PRODUCTION

1st 24 hrs. Nat. _____

1st 24 hrs. after shot _____

Gas _____ Cu. Ft.

Dry Hole _____

Abandoned _____

Date

7/12/33 192*Oval Mannschick* Scout