


Form 51—5M—5-34—Palace

Form 51-5M-534-Palace
Map No. KANSAS Sec. 21 Twp. 16 R. 10^W

Well No. 1 Johansen Farm
Stanford & Gypsy Company

NORTH

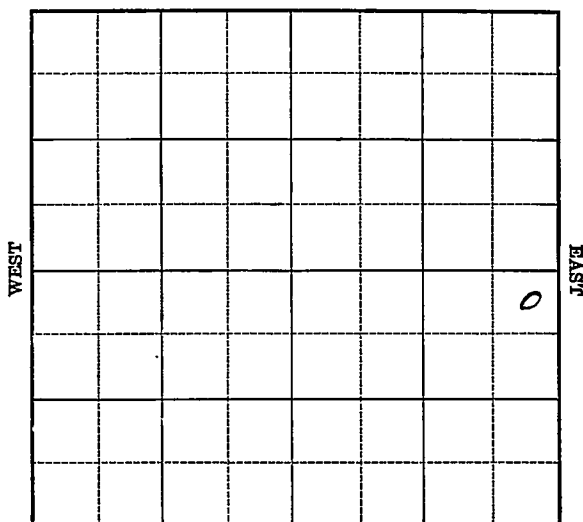

SOUTH

Location_____

Drilling Remarks

Rig Up_____

Drilling Remarks

RECORD

Cased_____in. _____ft.

Sand

Gas

Oil

Total Depth_____

PRODUCTION

1st 24 hrs. Nat.-----

1st 24 hrs. after shot_____

Gas _____ cu. ft. _____

Dry Hole_____

Abandoned-----

Ellsworth

Map No. KANSAS

Sec. 21 Twp. 16 R. 10W

Well No. 1-Johansen Farm

Stanolind & Gypsy Company

NORTH

330 Ft. from N. Line

_____ Ft. from S. Line

330 Ft. from E. Line

_____ Ft. from W. Line

WEST

EAST

SOUTH

Date 7/34

REPORT

8/15 Location
8/23 Rig
8/30 12" 239 WOC
9/6 log 1845
9/13 " 2777
9/20 Logging 2997 7" 3288 Rust
9/27 _____ 3316
10/4 Simpson 3311 Siliceous 3318
2900' oil Run 5" liner
10/11 Siliceous 3316 Corrected
TD 3321 1/2 2900' oil
10/18 1000 acid
10/24 Siliceous 3316 TD 3321 1/2
1000 acid 563 Bbls.

COMPLETED

Edenworth

KANSAS

Map No. 55 Sec. 21 Twp. 16 R. 10W

Well No. 1-Johansen

Haholind & Sypers Company

Contractor

FIRST REPORT

SECTION PLAT

			10

330 Ft. from N. Line

Ft. from S. Line

330 Ft. from E. Line

Ft. from W. Line

Location ✓

Rig up

Drilling and Remarks:

RECORD

Cased _____ in., _____ ft.

Sand _____

Gas _____

Oil _____

Total Depth _____

PRODUCTION

1st 24 hrs. Nat. _____

1st 24 hrs. after shot _____

Gas _____ Cu. Ft.

Dry Hole _____

Abandoned _____

Date

8-15-34 19

MANNECHIRE

Scout

Eldersmith

KANSAS

Form 28-1M Bks. 2-28

Map No. 55 Sec. 21 Twp. 16 R. 10W

Well No. 1- Johansen

Standind & Gypsy Company

Contractor

COMPLETED

330 Ft. from N. Line

_____ Ft. from S. Line

330 Ft. from E. Line

_____ Ft. from W. Line

SECTION PLAT

			0

Location _____

Rig up _____

Drilling and Remarks:

1000 acid

563 bbls

RECORD

Cased _____ in., _____ ft.


Gas _____

Oil _____

Total Depth 3321 1/2

PRODUCTION

1st 24 hrs. Nat. _____

1st 24 hrs. after shot _____

Gas _____ Cu. Ft.

Dry Hole _____

Abandoned _____

Date

10-24-34 19

ORVAL MANNSCHRECK

Scout