


KANSAS Ellsworth county

Section 21 Township 16 Range 10W

Well No. #1, Stollenberg *Johanssen*

Company Artmell

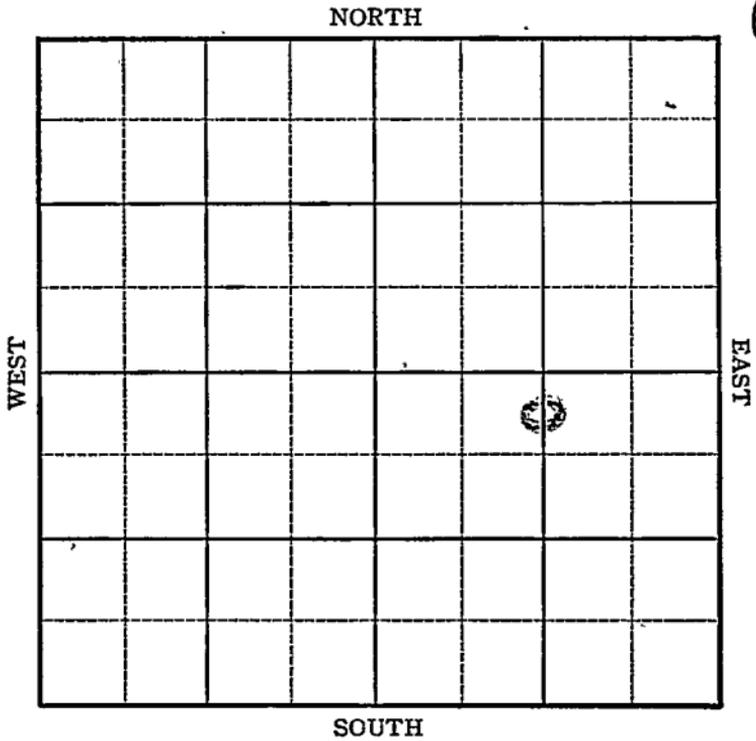

Sec. 21 Twp. 16 R. 10W

Well No. #1 ~~Stoltenberg~~ Johansen Farm
Artmell Company

Stoltenberg


330 Ft. from N. Line

_____ Ft. from S. Line

1320 Ft. from E. Line

_____ Ft. from W. Line

CNL N/2 SE

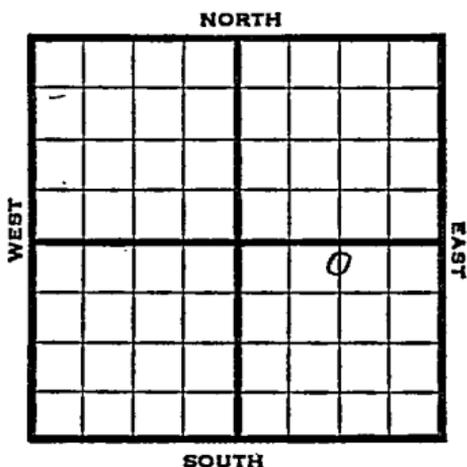

1946 Elev. 1864 REPORT

5/15	8" @ 343 Lans 3000 Drlg. 3204'
5/21	Arb 3327-60 TD 5" @ 3 360 RUST
5/29	" " "
6/5	TD 3361 1400' fluid 12 hrs. 25% wtr.
6/12	" " "
6/18	12 shots 3334-43
6/26	" "
7/3	Pump 100 oil 24 hrs
7/9	" " "
7/17	Arb. 3327 5" @ 3360 TD 3361 Pump 60 oil plus 10% W. Pot. Grav. 42.0

COMPLETED

KANSAS

Kansas Pool Name StoltenbergMap No. 55 Sec. 21 Twp. 16 R. 10WWell No. 1 StoltenbergArtmell Company

FIRST REPORT

Contractor

C N L $N\frac{1}{2}$ SE

SECTION PLAT

330 Ft. from N. Line Ft. from S. Line1320 Ft. from E. Line Ft. from W. Line

Ellsworth County

Location Rig up

Drilling and Remarks:

5" @ 3494ams 3000The 193204

RECORD

Cased in., ft.Sand Gas Oil Total Depth

PRODUCTION

1st 24 hrs. Nat. 1st 24 hrs. after shot Gas Cu. Ft.Dry Hole Abandoned

Date

MAY 15 1946 19

S. J. LEWIS Scout

KANSAS

Kansas Pool Name Stoltenberg

Map No. 56 Sec. 21 Twp. 16 R. 10W

Well No. 1 Johanssen

Artmell

Company

CORRECTION

Contractor

C N L SE

SECTION PLAT

330 Ft. from N. Line

_____ Ft. from S. Line

1320 Ft. from E. Line

_____ Ft. from W. Line

		o	

Ellsworth County

RECORD

Location _____

Cased _____ in., _____ ft.

Rig up _____

Sand _____

Drilling and Remarks:

Gas _____

Oil _____

Total Depth _____

Reported as

#1 Stoltenberg

PRODUCTION

1st 24 hrs. Nat. _____

1st 24 hrs. after shot _____

Gas _____ Cu. Ft.

Dry Hole _____

Abandoned _____

Date

JUN 26 1946 19

S. J. LEWIS Scout

KANSAS

Pool Name Steltenberg Pool

KANSAS

Kansas

Map No. 55 Sec. 21 Twp. 16 R. 10WWell No. 1 JohanssenArtmell Company**COMPLETED**

Contractor

C N L SE

E11864
SECTION PLAT

330 Ft. from N. Line Ft. from S. Line1320 Ft. from E. Line Ft. from W. LineEllsworth CountyLocation Rig up

Drilling and Remarks:

Cor #33275" @ 3360Pump 60 oil +
10% N.P.D.42 @ 1/4**RECORD**Cased in., ft.Sand Gas Oil Total Depth 2361**PRODUCTION**1st 24 hrs. Nat. 1st 24 hrs. after shot Gas Cu. Ft.Dry Hole Abandoned

Date

JUL 17 1946 19S. J. LEWIS Scout