

KANSAS


FORM 51 5M 11-44 PETROL

Ellsworth County

Section 21 Township 16 Range 10W

Well No. #2 Johanssen

Company Artmell Pet

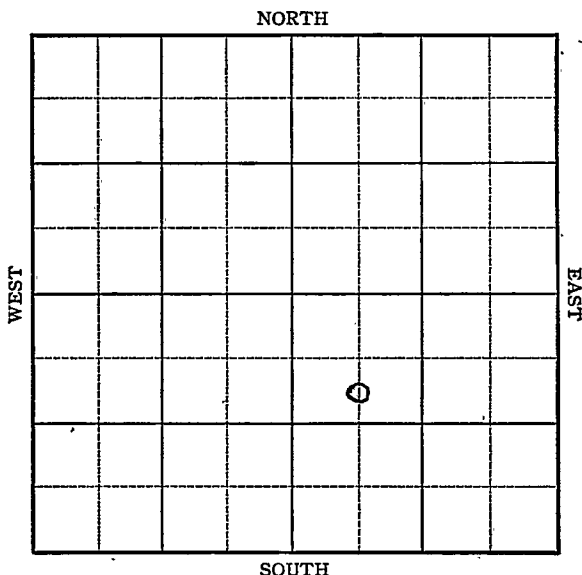

KANSAS

Ellsworth County

Sec. 21 Twp. 16 R. 10W

Well No. #2 Johanssen Farm

Artmell Pet.

Company

Stoltenberg


990 Ft. from N. Line

Ft. from S. Line

Ft. from E. Line

660 Ft. from W. Line

CSL NW SE

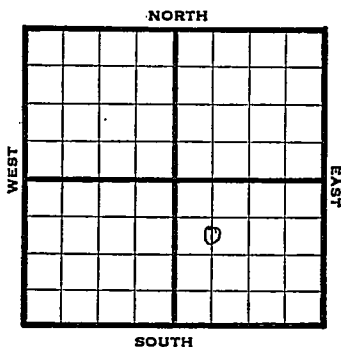

1946

1851

REPORT

6/26

8" @ 330

Drlg. 2570'

7/4

Lans 2994

Cong 3296

Arb 3299

TD 3312'

5" @ 3303 RUST

7/9

" "

7/16

TD 3318'

2500 acid 670' fluid 8 hrs

7/23

" " "

7/30

" " "

8/6

" " "

8/13

" " "

8/21

Arb. 3299

5" @ 3303

2500 acid.

TD 3318

Pump 68 oil plus 10% Wtr. pot.

Grav. 42.0

COMPLETED

KANSAS

Kansas Pool Name StoltenbergMap No. 53 Sec. 21 Twp. 16 R. 10WWell No. 2 JohanssenArtmell Pet.

Company

FIRST REPORT

Contractor

C S L NW SE

SECTION PLAT

990 Ft. from N. Line Ft. from S. Line Ft. from E. Line660 Ft. from W. Line

Ellsworth CountyLocation Rig up

Drilling and Remarks:

8" @ 330'

2570'

RECORD

Cased in., ft.Sand Gas Oil Total Depth

PRODUCTION

1st 24 hrs. Nat. 1st 24 hrs. after shot Gas Cu. Ft.Dry Hole Abandoned

Date

JUN 26 1946

19

S. J. LEWIS

Scout


KANSAS

Kansas

Pool Name StoltenbergMap No. 55 Sec. 21 Twp. 16 R. 10WWell No. 2 JohanssenArtmell Pet. Company**COMPLETED**

Contractor

C S L NW SE

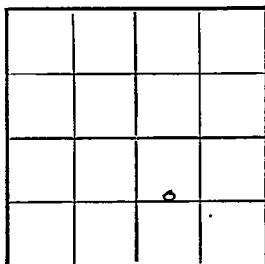E 1/1887
SECTION FLAT990 Ft. from N. Line Ft. from S. Line Ft. from E. Line660 Ft. from W. Line

Ellsworth County

Location Rig up

Drilling and Remarks:

*CR 43289**5" @ 3303**2000 acid**Pump 68 oil + 10%**Water Pad**42 9/16***RECORD**Cased in., ft.Sand Gas Oil Total Depth 3318**PRODUCTION**1st 24 hrs. Nat. 1st 24 hrs. after shot Gas Cu. Ft.Dry Hole Abandoned

Date

AUG 21 1946 19 S. J. LEWIS Scout