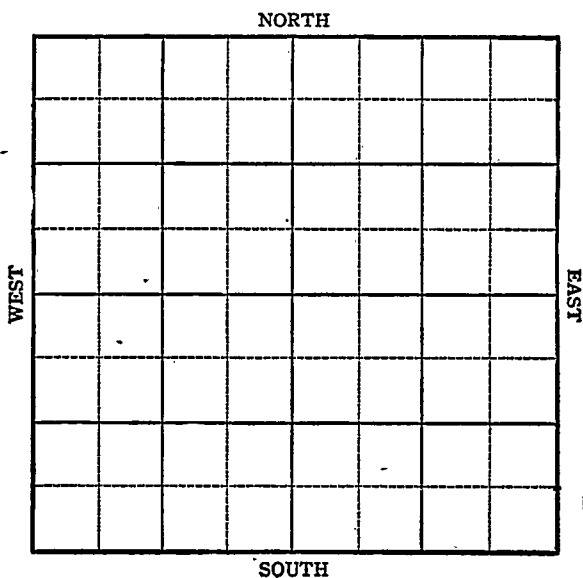


KANSAS

Ellsworth

Section 21 Township 16 Range 10WWell No. #3 Stoltenberg "B"Company Inglis & Alpine

KANSAS

Ellsworth County

Sec. 21 Twp. 16 R. 10W

Well No. #3 Stoltenberg "B" Farm

Ingling & Alpine Company

Stoltenberg

NORTH

 Ft. from N. Line


330 Ft. from S. Line

 Ft. from E. Line

990 Ft. from W. Line

WEST

EAST

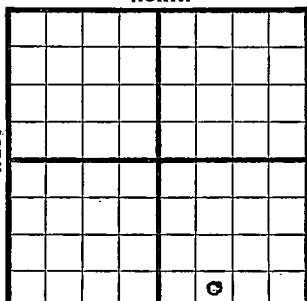

SOUTH

SE SW SE

1944

REPORT

8/16 8" -322

1140' Drlg

8/23 Drlg. 2470

8/30 Lans 2990

Drlg. 3076

9/8 Arb 3311-12 TD SO

5" @ 3311 $\frac{1}{2}$ RUST

9/13 " " " " " "

9/21 " " " " " "

9/28 " " " " " "

10/4 Arb 3311

3/13 5" @ 3311 $\frac{1}{2}$

1000 acid

Pump 50 Pot.

TD 3326

Grav. 42.6

COMPLETED

KANSAS

Pool Name StoltenbergMap No. 55 Sec. 21 Twp. 16 R. 10WWell No. 3 Stoltenberg "B"Ingling & Alpine Company

FIRST REPORT

Contractor

SE SW SE

SECTION PLAT

			1
			6

 Ft. from N. Line330 Ft. from S. Line Ft. from E. Line990 Ft. from W. Line

Ellsworth

Location Rig up

Drilling and Remarks:

8" - 322

1110

RECORD

Cased in., ft.Sand Gas Oil Total Depth

PRODUCTION

1st 24 hrs. Nat. 1st 24 hrs. after shot Gas Cu. Ft.Dry Hole Abandoned

Date


AUG 16 1944 19

S. J. LEWIS Scout

Pool Name StoltenbergMap No. 55 Sec. 21 Twp. 16 R. 10WWell No. 3 Stoltenberg "B"Ingling and Alpine CompanyCOMPLETED Contractor

SE SW SE

SECTION PLAT

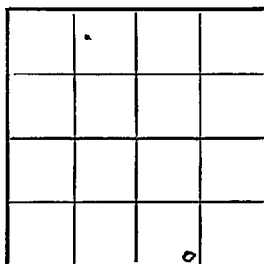 Ft. from N. Line330 Ft. from S. Line Ft. from E. Line990 Ft. from W. LineEllsworthEllis CountyLocation Rig up

Drilling and Remarks:

Cr 3311
5" @ 3311 1/2
1000 acid
Pump 50 Bx

42 1/2 Gr

RECORD

Cased in., ft.Sand Gas Oil Total Depth 3326

PRODUCTION

1st 24 hrs. Nat. 1st 24 hrs. after shot Gas Cu. Ft.Dry Hole Abandoned

Date

OCT 4 194419S. J. LEWISScout