


Section 6 Township 32 Range 6-E

Well Number #1-Cook Rising

Company G. H. Frost AlyWARD Prod

NORTH

OFFSET

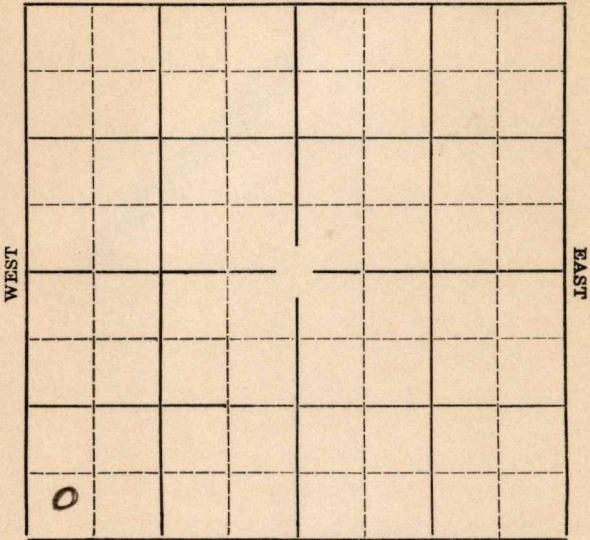


SOUTH

Sec. 6 Twp. 32 R. 6E

Well No. ~~#1 Cook~~ #1 Rising Farm

~~G.H. Frost~~ Alyward Prod Company

NORTH

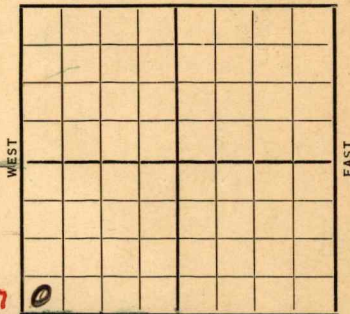

Ft. from N. Line

330' Ft. from S. Line

Ft. from E. Line

330' Ft. from W. Line

ELEVATION 1339

~~1339~~

Date 1936

REPORT

DONATED 40 ACRES

10/7 Location.

10/15 Machine.

10/22--

10/29 Rigging up.

11/6---

11/12 Shut down.

11/19--

11/27 Spud.

12/3 12" @ 586'. Drlg. 685'.

12/10 Drlg. 1360'.

12/17 10" @ 1438'. 1530 U R 10".

12/30 ~~From 2290 to 2296 feet~~
~~Testing (Drill Page 100)~~

12/31 Sand 2278-86 T.D. 2290

Think this is Layton sand
Hole filled up 400 feet oil in 12 hours Could not bail to bottom
Shot this afternoon Will try to have report by tomorrow noon (Tel-Lewis)

OVER

1937

1/3/37...Pay 2290

T.D. 2314

shot 50 qts filled up 400 feet
oil after shot

C. O. to run 5" casing

No water

Will drill to Bartlesville Sand

1/7 T. D. 2325'. 5 bailers water
 $\frac{1}{2}$ bailer oil per hr.

1/14 6" @ 2434'. Drlg. 2460'.

1/21 2712' straight ream 6".

1/26..Top Bartlesville

T.D. 3030 Hole Full Water

Shut down for orders (Telegram)

1/29--Top Bartlesville 2952

Light show ~~xx~~ oil

6 bailers water 3000-3023

Hole full water 3035-40

T.D. 3040 Fishing tools

Will drill to Mississippi (Tel)

2/4 Show oil 3000'. Miss. L. 3074

T. D. 3078'. Hole full

water 3035-45'.

S. D. 3078'.

2/10 Bart Sand 2952'.

Mississippi Lime 3074'.

T. D. 3081'.

ABANDONED

KANSAS

Map No. 2 Sec. 6 Twp. 32 R. 6E

Well No. 1 Cook

C. H. Frost Company

Contractor

offset

SECTION PLAT

_____ Ft. from N. Line

330 Ft. from S. Line

_____ Ft. from E. Line

330 Ft. from W. Line

FIRST REPORT

Location ✓

Rig up _____

Drilling and Remarks:

RECORD

Cased _____ in., _____ ft.

Sand _____

Gas _____

Oil _____

Total Depth _____

PRODUCTION

1st 24 hrs. Nat. _____

1st 24 hrs. after shot _____

Gas _____ Cu. Ft.

Dry Hole _____

Abandoned _____

Date

OCT 7 1936 19

S. J. LEWIS Scout

KANSAS

Map No. 2 Sec. 6 Twp. 32 R. 6E

Well No. 1 Rising

Clyward Prods Company

Contractor

SECTION PLAT

_____ Ft. from N. Line

330 Ft. from S. Line

_____ Ft. from E. Line

330 Ft. from W. Line

CORRECTION

Location _____

Rig up _____

Drilling and Remarks:

*Reported as
C.H. Prods
on the Cook
farm.*

RECORD

Cased _____ in., _____ ft.

Sand _____

Gas _____

Oil _____

Total Depth _____

PRODUCTION

1st 24 hrs. Nat. _____

1st 24 hrs. after shot _____

Gas _____ Cu. Ft.

Dry Hole _____

Abandoned _____

Date

OCT 28 1936 19

S. J. LEWIS Scout

KANSAS

Map No. 2 Sec. 6 Twp. 32 R. 6E

Well No. 1 Rising

Alward Prod & Oil Company

Contractor

SECTION PLAT

_____ Ft. from N. Line

330 Ft. from S. Line

_____ Ft. from E. Line

330 Ft. from W. Line

ABANDONED

Location _____

Rig up _____

Drilling and Remarks:

Bar. sand

2952.

Mississippi L.

3074.

D & H

RECORD

Cased _____ in., _____ ft.

Sand _____

Gas _____

Oil _____

Total Depth 3081

PRODUCTION

1st 24 hrs. Nat. _____

1st 24 hrs. after shot _____

Gas _____ Cu. Ft.

Dry Hole _____

Abandoned _____

Date

FEB 10 1937

19

S. J. LEWIS Scout