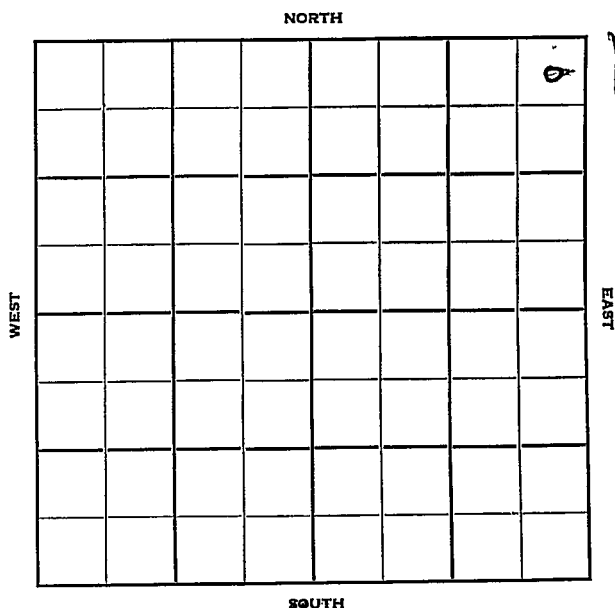


Section 22 Township 16 Range 10WWell No. #1 StoltenbergCompany Don Ingling

Ellsworth

KANSAS

Sec. 22 Twp. 16 R. 10W

Well No. #1 Stoltenberg Farm

Don Ingling Company

Don Ingling - Contr. Contractor


330' Ft. from N. Line

 Ft. from S. Line

330' Ft. from E. Line

 Ft. from W. Line

NE NE NE

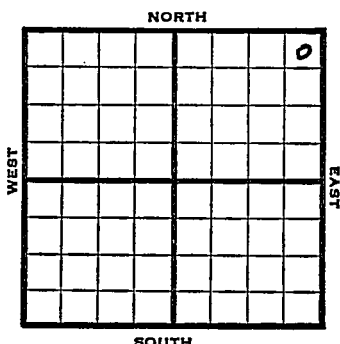

1952

1877 DF

REPORT

7/2

Spud 6-24-52

8" @ 260

Anhy 680

Drlg. 2005'

7/9

KC 3053 Drlg. 3270'

7/16

Spud 6-24-52

D & A TD 3452' 8" @ 260

Anhy 680' KC 3053' Cong. 3388'

Simp. 3421' Arb. 3450'

TD 3452' D & A

ABANDONED

County Ellsworth State Kansas
 Sec. 22 (Blk. 16) (Sur. 10W) Map No. 16
 Operator Don Ingling
 Well No. 1 Farm Stoltenberg
 Elev. 1877 Location NE NE NE

						0

330 Ft. From N Line NE
330 Ft. From E Line Quarter

Ist. Report

Completion JUL 16 1952

Remarks

Don Ingling - Contr.

Spudding Date 6-24-52

Drlg. Data D & A TD 3452
8" @ 260 Anhy 680 KC 3053 Cong. 3388
Simp. 3421 Arb. 3450 TD 3452

D & A